

PROJECT INFORMATION:

PROPERTY OWNER: LAKEWOOD INVESTORS LLC
12030 SUNRISE VALLEY DR STE 450
RESTON, VA 20191

SITE ADDRESS: 0 JACKSON HWY,
CHEHALIS, WA 98532

PARCEL NUMBER: 010799001000

ZONING (CITY): UGA – URBAN GROWTH AREA

LOTS: 1 EXISTING

SITE SOILS: GALVIN SILT LOAM, 0 TO 8 PERCENT
SLOPES & SCAMMAN SILTY CLAY LOAM,
5 TO 15 PERCENT SLOPES

OWNER: CITY MAIN – METERED

SANITARY SEWER: CITY MAIN – GRAVITY

GRADING: 19000± CY FILL
450± CY CUT

SURVEY INFORMATION:

VERTICAL DATUM
NAVD 88

BASIS OF BEARING
HOLDING RECORD OF SURVEY RECORDED UNDER AUDITOR'S FILE
NO. 3325715, IN BOOK 27 OF SURVEYS AT PAGE 53, RECORDS
OF LEWIS COUNTY.

GEOTECHNICAL INFORMATION:

A GEOTECHNICAL REPORT WAS NOT PREPARED FOR THIS
PROJECT. IN LIEU OF A REPORT ALL CONSTRUCTION SHALL
COMPLY WITH STANDARD SPECIFICATIONS.

TOPOGRAPHIC INFORMATION:

TOPOGRAPHIC INFORMATION DEPICTED IN THESE DRAWINGS WAS
PROVIDED BY LEWIS COUNTY GIS DATA & GOODMAN LAND
SURVEYING, INC. TOPOGRAPHIC INFORMATION WAS NOT FIELD
VERIFIED BY FULLER DESIGNS.

LEGEND:

LINETYPES:

EXISTING	PROPOSED	DESC.
---	---	LOT LINE
---	---	EASEMENT
-X-X-	-X-X-	FENCING
---	---	DITCH/WETLAND
---	---	RD CENTERLINE
---	---	RIGHT OF WAY
---	---	EDGE OF PAVEMENT
---	---	EDGE OF GRAVEL
---	---	BUILDING
---	XX	CONTOUR LINE (MAJOR)
---	---	CONTOUR LINE (MINOR)
E	E	ELECTRICAL UNDERGROUND
OE	OE	ELECTRICAL OVERHEAD
OT	OT	TELECOMMUNICATION
G	G	GAS MAIN
W	W	WATER MAIN
SS	SS	SEWER MAIN
FM	FM	FORCE MAIN
ST	ST	STORM MAIN
---	---	CULVERT
---	SF	SILT FENCE
---	---	PROJECT AREA
---	---	CONSTRUCTION PHASE LINE

SYMBOLS:

EXISTING	PROPOSED	DESC.
X	→	FLOW DIRECTION ARROW
○	○	SPOT ELEVATION
○	○	SEWER MANHOLE
○	○	STORM MANHOLE
□	□	CATCH BASIN
○	○	INSPECTION PORT
○	○	WELL
○	○	WATER METER BOX
○	○	WATER VALVE
○	○	HYDRANT
○	○	BLOWOFF ASSEMBLY
△	△	TRUST BLOCK
△	△	END CAP
△	△	GAS VALVE
○	○	POLE
○	○	TREE

HATCH:

EXISTING	PROPOSED	DESC.
▒	▒	ASPHALT PAVEMENT
▒	▒	GRAVEL AREA
▒	▒	CONCRETE SIDEWALK

ABBREVIATIONS:

AC	ASPHALT CONCRETE
BCR	BEGIN CURB RETURN
BM	BENCHMARK
BVCS	BEGIN VERTICAL CURVE STATION
BCVE	BEGIN VERTICAL CURVE ELEVATION
CATV	CABLE TELEVISION
CB	CATCH BASIN
CL	CENTERLINE
CMP	CORRUGATED METAL PIPE
CO	CLEAN OUT
CY	CUBIC YARD
°	DEGREES
∅	DIAMETER
EE	ELECTRICAL
ECR	END CURB RETURN
EOP	EDGE OF PAVEMENT
ELEV	ELEVATION
EVCS	END VERTICAL CURVE STATION
EVCE	END VERTICAL CURVE ELEVATION
EX	EXISTING
FF	FINISH FLOOR
FG	FINISH GRADE
FH	FIRE HYDRANT
FL	FLOW LINE
FM	FORCE MAIN
G	GAS
GB	GRADE BREAK
GM	GAS METER
GV	GATE VALVE
HDPE	HIGH DENSITY POLYETHYLENE
HP	HIGH POINT
IE	INVERT ELEVATION
K	CALCULATED CURVE VALUE
L	LENGTH
LCV	LENGTH VERTICAL CURVE
LF	LINEAR FEET
M	METER
MAX	MAXIMUM
MH	MAN HOLE
MIN	MINIMUM
MJ	MECHANICAL JOINT
NFC	NOT FOR CONSTRUCTION
OHP	OVER HEAD POWER
P	POWER
PC	POINT OF CURVATURE
PI	POINT OF INTERSECTION
PL	PROPERTY LINE
POB	POINT OF BEGINNING
POC	POINT OF CONNECTION
PRC	POINT OF REVERSE CURVATURE
PT	POINT OF TANGENCY
PVC	POLY-VINYL CHLORIDE
R	RADIUS
RCP	REINFORCED CONCRETE PIPE
RD	ROAD
RFC	RELEASED FOR CONSTRUCTION
ROW	RIGHT OF WAY
RPBA	REDUCED PRESSURE BACKFLOW ASSEMBLY
S	SLOPE
SF	SQUARE FOOT
SD	STORM DRAIN
SS	SANITARY SEWER
ST	STORM
STA	STATION
SW	SIDEWALK
T	TELEPHONE
TB	TRUST BLOCK
TC	TOP OF CURB/CONCRETE
TESC	TEMPORARY EROSION AND SEDIMENT CONTROL
TC	TOP OF GRATE
TYP	TYPICAL
UGP	UNDERGROUND POWER
W	WATER
WL	WATER LEVEL
WM	WATER METER
WV	WATER VALVE
±	APPROXIMATELY
%	PERCENT
Δ	DELTA


DRAWING CONTENTS:

- C0.1 – CIVIL COVER SHEET
- C1.1 – EX. CONDITION, DEMO AND TESC PLAN
- C2.1 – HORIZONTAL CONTROL PLAN
- C2.2 – LOT LAYOUT
- C3.1 – OVERALL GRADING PLAN
- C4.1 – FULL SITE STORM DRAINAGE PLAN
- C5.1 – FULL SITE SEWER PLAN
- C6.1 – FULL SITE WATER PLAN

JACKSON VILLA 4

SECTION 03 TOWNSHIP 13N RANGE 02W
CHEHALIS, WASHINGTON

VICINITY MAP

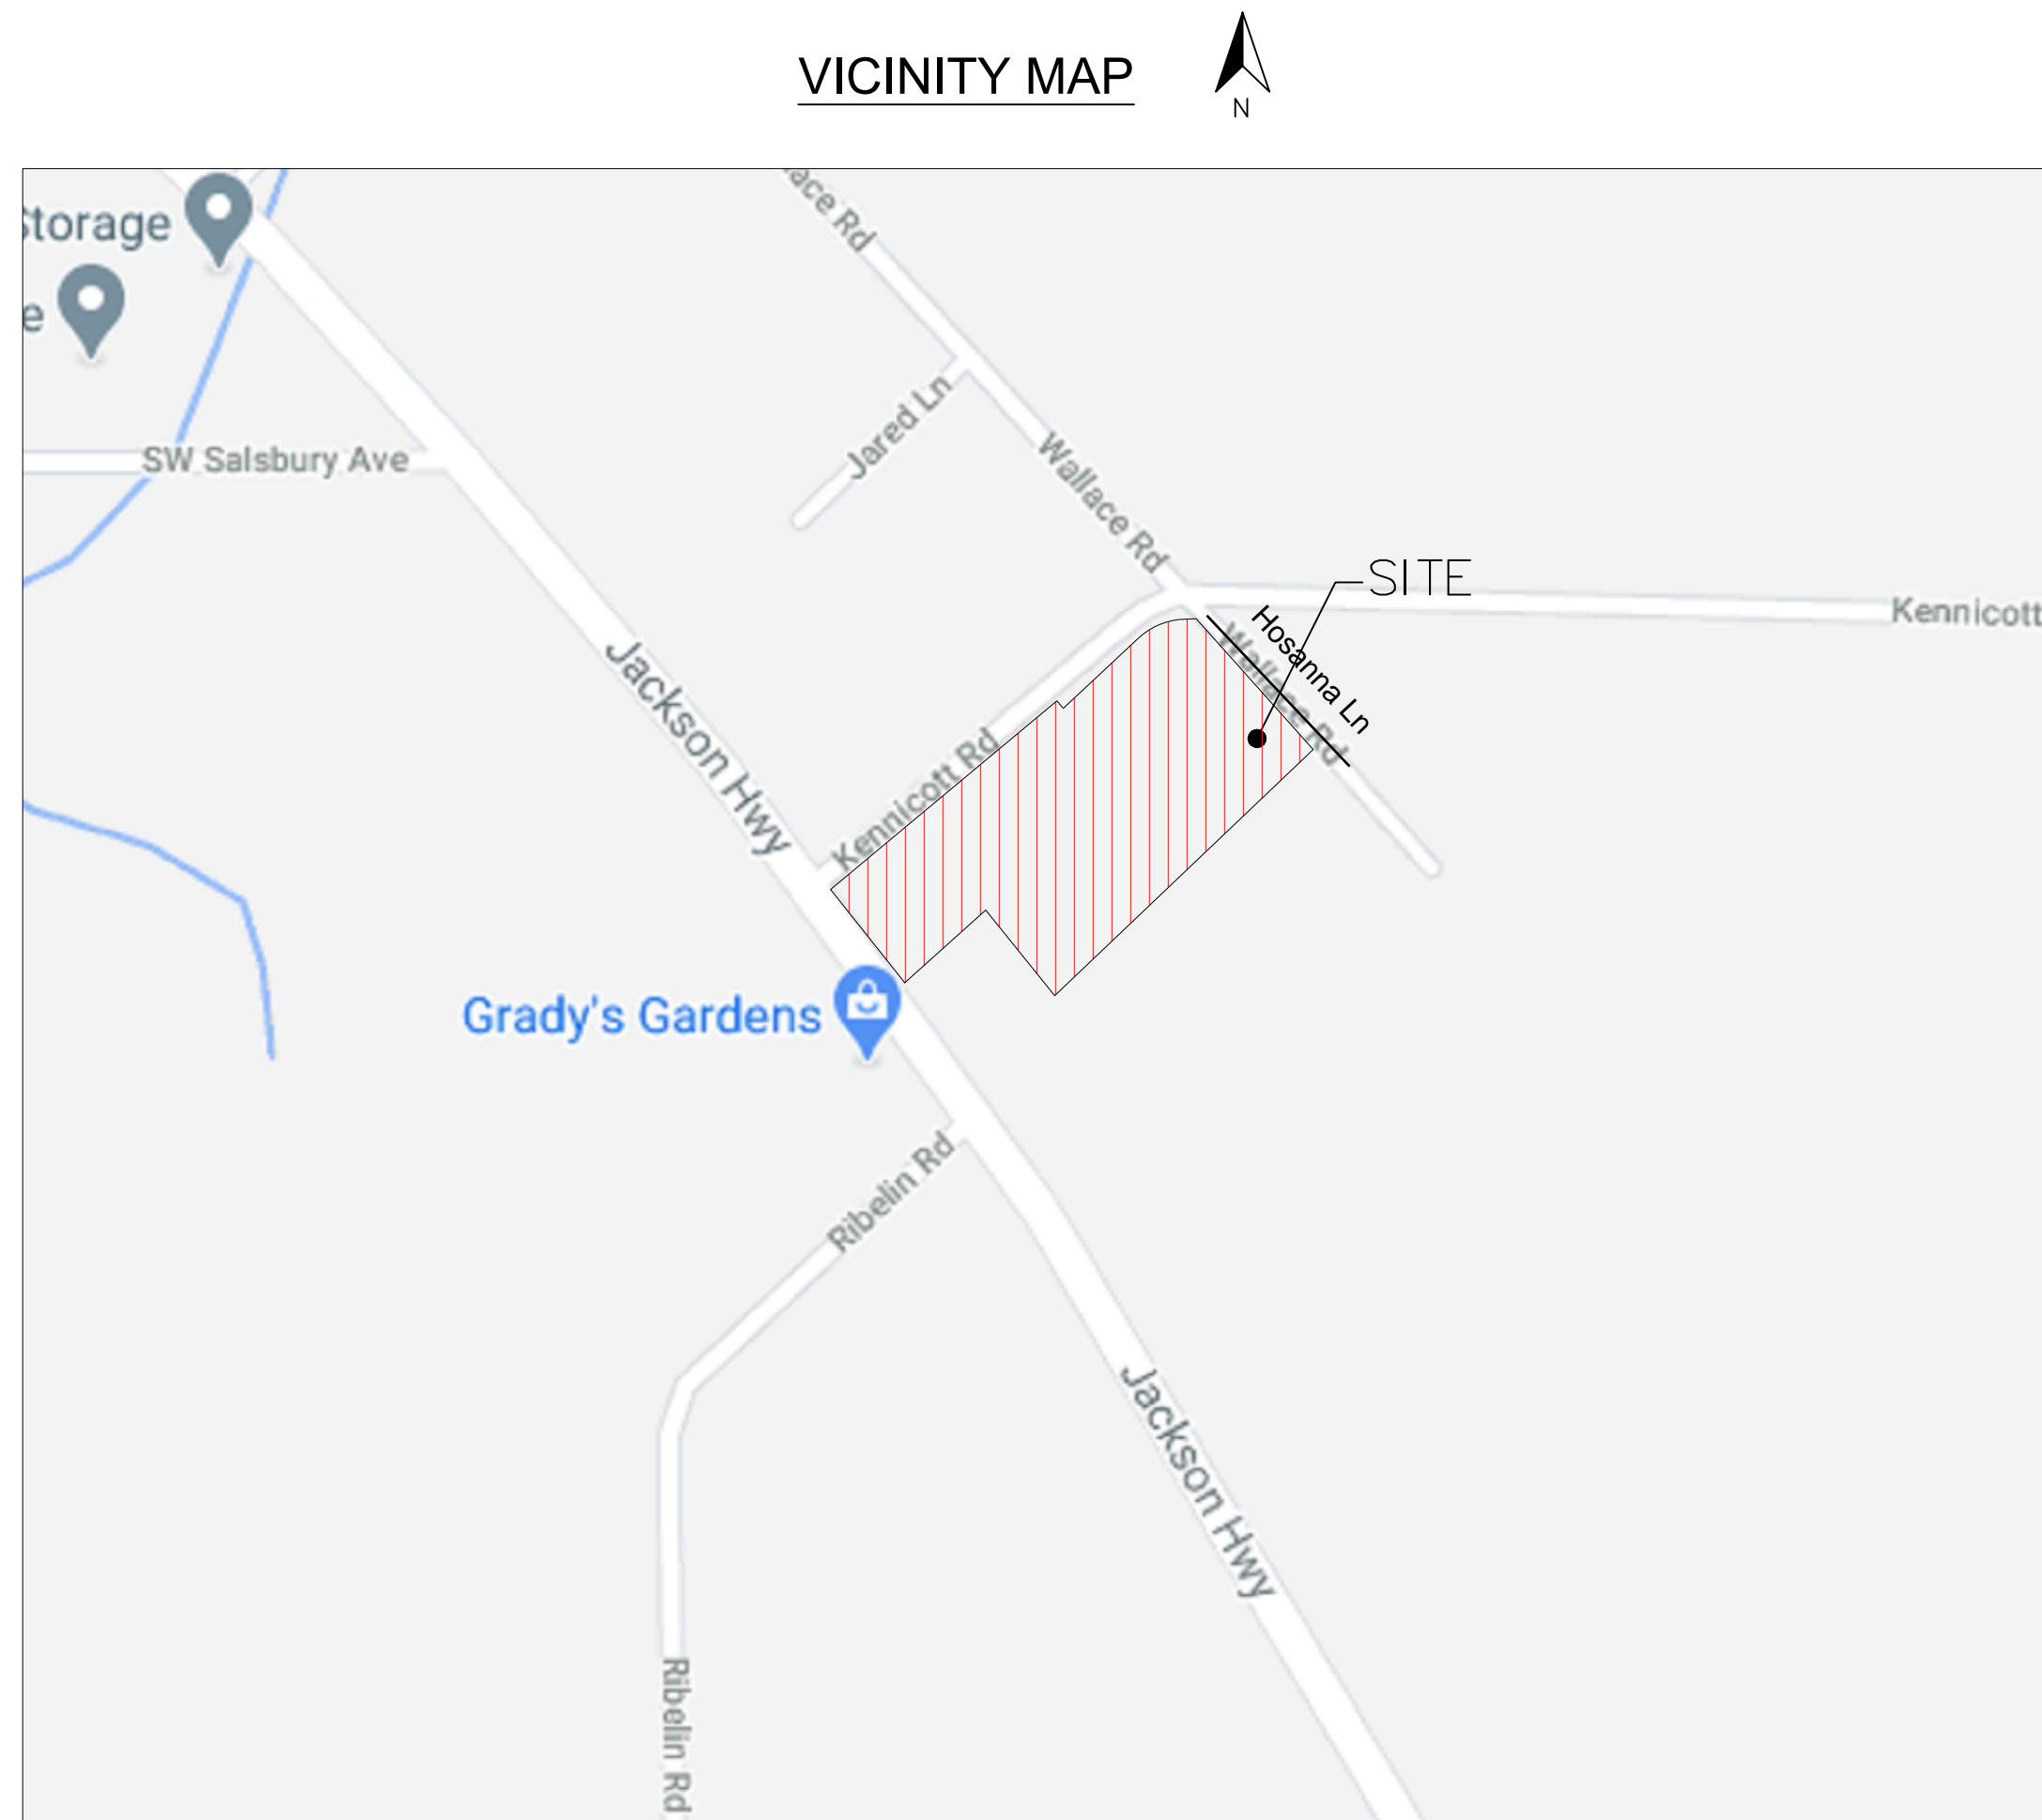

UTILITIES LOCATE NOTE:

EXISTING UTILITIES LOCATION SHOWN IN THIS PLAN SET IS BASED ON INFORMATION OBTAINED FROM VARIOUS RECORDS RESEARCH, ASBUILT DATA, AND FIELD MEASUREMENTS. FULLER DESIGNS ASSUMES NO RESPONSIBILITY FOR EXACT LOCATION OF UTILITIES EITHER SHOWN OR NOT SHOWN IN THESE DRAWINGS. CONTRACTOR SHALL VERIFY THE EXACT SIZE, DEPTH, LOCATION, AND ARRANGEMENT OF ALL UTILITIES PRIOR TO CONSTRUCTION. CONTRACTOR SHALL CALL UNDERGROUND LOCATE AT 811 PRIOR TO PERFORMING CONSTRUCTIONS ACTIVITIES.



PRELIMINARY
FOR PERMIT ONLY

PROJECT SPECIFICATIONS:

THE WORK ON THIS PROJECT SHALL BE PERFORMED IN ACCORDANCE WITH THE STANDARD SPECIFICATIONS FOR RD, BRIDGE AND MUNICIPAL CONSTRUCTION, 2020 WASHINGTON STATE DEPARTMENT OF TRANSPORTATION (WSDOT) (HEREAFTER "STANDARD SPECIFICATIONS").

ALSO INCORPORATED INTO THESE CONTRACT DOCUMENTS BY REFERENCE ARE:

- A. MANUAL ON UNIFORM TRAFFIC CONTROL DEVICES (MUTCD)
- B. CITY RD STANDARDS
- C. CITY DRAINAGE STANDARDS
- D. THE INTERNATIONAL BUILDING CODE (IBC)

CURRENT EDITIONS OF THESE STANDARDS SHALL BE USED WHICH EXIST ON THE DATE OF CONTRACT ACCEPTANCE.

CONTRACTOR SHALL OBTAIN COPIES OF THESE PUBLICATION AT CONTRACTOR'S OWN EXPENSE.

THE CONTRACTOR IS RESPONSIBLE FOR PROVIDING ALL LABOR, MATERIALS, TOOLS, EQUIPMENT, TRANSPORTATION, SUPPLIES AND INCIDENTALS REQUIRED TO COMPLETE ALL WORK SHOWN ON THESE DRAWINGS. ONCE WORK IS COMPLETED CONTRACTOR SHALL OBTAIN ACCEPTANCE BY THE COUNTY AND PROJECT ENGINEER.

THE INTENT OF THESE DRAWINGS IS TO PRESCRIBE A COMPLETE PROJECT. OMISSIONS FROM THE DRAWINGS OF DETAIL OF WORK WHICH IS NECESSARY TO CARRY OUT THE INTENT OF THE DRAWINGS SHALL NOT RELIEVE THE CONTRACTOR FROM PROVIDING THE OMITTED WORK.

ANY PROPOSED ALTERATIONS BY THE CONTRACTOR AFFECTING THE REQUIREMENTS AND INFORMATION IN THESE DRAWINGS SHALL BE IN WRITING AND WILL REQUIRE APPROVAL OF THE ENGINEER AND INSPECTOR.

WORK IN RIGHT OF WAY:

CONTRACTOR SHALL OBTAIN A RIGHT OF WAY PERMIT PRIOR TO COMMENCING ANY WORK LOCATED IN RIGHT OF WAY. ALL WORK PERFORMED IN THE RIGHT OF WAY SHALL ADHERE TO DRAWINGS, STANDARD SPECIFICATIONS, AND REQUIREMENTS OUTLINED IN THE RIGHT OF WAY PERMIT.

RECORD DRAWINGS:

FULLER DESIGNS IS REQUIRED BY THE CITY TO PROVIDE RECORD DRAWING CERTIFICATION PRIOR TO FINAL CITY ACCEPTANCE. FULLER DESIGNS WILL NOT CERTIFY RECORD DRAWINGS WITHOUT INSPECTION OF BELOW GRADE UTILITIES AND STRUCTURES. PRIOR TO BACKFILLING, CONTRACTOR SHALL NOTIFY FULLER DESIGNS OF NECESSARY INSPECTIONS.

CONTRACTOR TO VERIFY ALL DIMENSIONS IN FIELD AND NOTIFY ENGINEER OR INSPECTOR OF INCONSISTENCIES PRIOR TO START OF CONSTRUCTION. CONTRACTOR SHALL MAINTAIN ONE SET OF THE CONTRACT DRAWINGS THAT SHALL INCLUDE: ANY ALTERATIONS OR LOCATION OF UNDERGROUND UTILITIES ENCOUNTERED DURING THE PROGRESS OF THE PROJECT. ANY ALTERATIONS MADE TO THE IMPROVEMENTS BEING INSTALLED. MARKED DRAWINGS SHALL BE CLEAR AND LEGIBLE. DRAWINGS SHALL BE MARKED "RECORD DRAWINGS" AND SHALL BE SUBMITTED TO THE ENGINEER UPON PROJECT COMPLETION.

CONTRACTOR LIABILITY NOTE:

CONTRACTOR AGREES TO ASSUME SOLE AND COMPLETE RESPONSIBILITY FOR THE JOB SITE CONDITIONS DURING THE COURSE OF CONSTRUCTION OF THIS PROJECT. THIS REQUIREMENT SHALL APPLY CONTINUOUSLY THROUGHOUT PROJECT EXECUTION AND NOT BE LIMITED TO WORKING HOURS. CONTRACTOR SHALL PROGRESS WORK IN A MANNER THAT SHALL INDEMNIFY AND HOLD FULLER DESIGNS HARMLESS FROM ALL LIABILITY IN CONNECTION WITH CONTRACTOR'S PERFORMED WORK.

REMOVAL OF UNSUITABLE MATERIALS:

IF UNSUITABLE MATERIALS AS DEFINED BY THE STANDARD SPECIFICATIONS ARE ENCOUNTERED, THIS MATERIAL SHALL BE REMOVED TO THE DEPTH REQUIRED BY THE ENGINEER OR INSPECTOR AND REPLACED WITH SUITABLE MATERIAL.

UNSUITABLE MATERIAL SHALL BE REMOVED FROM THE SITE AND HAULED TO A WASTE SITE OBTAINED BY THE CONTRACTOR. PRIOR TO REMOVAL, CONTRACTOR SHALL NOTIFY PROJECT OWNER SO MEASUREMENT/PAYMENT CAN BE MADE PER TON OF UNSUITABLE MATERIAL REMOVED.

EROSION CONTROL NOTE:

EROSION CONTROL MEASURES ARE NOT LIMITED TO THE ITEMS ON THESE PLANS. CONTRACTOR IS RESPONSIBLE FOR THE INSTALLATION AND MAINTENANCE OF ALL EROSION CONTROL MEASURES. NO SILTATION OF EXISTING OR PROPOSED DRAINAGE STRUCTURES WILL BE PERMITTED. CARE SHALL BE TAKEN TO PREVENT MIGRATION OF SOILS TO ADJACENT PROPERTIES. DISTURBED EARTH SHALL BE STABILIZED AS REQUIRED BY THE STANDARD SPECIFICATIONS. INDIVIDUAL DESIGNATED TO MONITOR EROSION CONTROL FACILITIES DURING CONSTRUCTION SHALL HAVE CESCL CERTIFICATION.

GENERAL NOTES:

CONTRACTOR SHALL COORDINATE ALL CONSTRUCTION ACTIVITIES WITH ADJACENT PROPERTY OWNERS. DRIVEWAYS AND UTILITY SERVICES SHALL REMAIN ACCESSIBLE AT ALL TIMES.

AREAS DISTURBED DURING CONSTRUCTION SHALL BE RESTORED TO THEIR ORIGINAL PRE-CONSTRUCTION STATE OR BETTER UPON COMPLETION OF WORK.

THESE DRAWINGS AND ALL ACCOMPANYING MATERIALS ARE COPYRIGHTED. UNAUTHORIZED COPYING OF THESE DOCUMENTS IS FORBIDDEN WITHOUT THE WRITTEN CONSENT OF FULLER DESIGNS.

DRAWING TITLE:	CIVIL COVER SHEET
	JACKSON VILLA 4
DATE:	02/22/21
DRAWN:	SD
CHECKED:	AF
SCALE:	N/A
PROJECT NAME:	JACKSON VILLA 4




FULLER DESIGNS
1101 KRESKY AVE
CENTRALIA, WA 98531
(360) 807-4420

REV.	DESCRIPTION:	DATE:
0	PRELIMINARY - FOR PERMIT	02/22/21

C0.1
1 OF 8

SECTION 03 TOWNSHIP 13N RANGE 02W

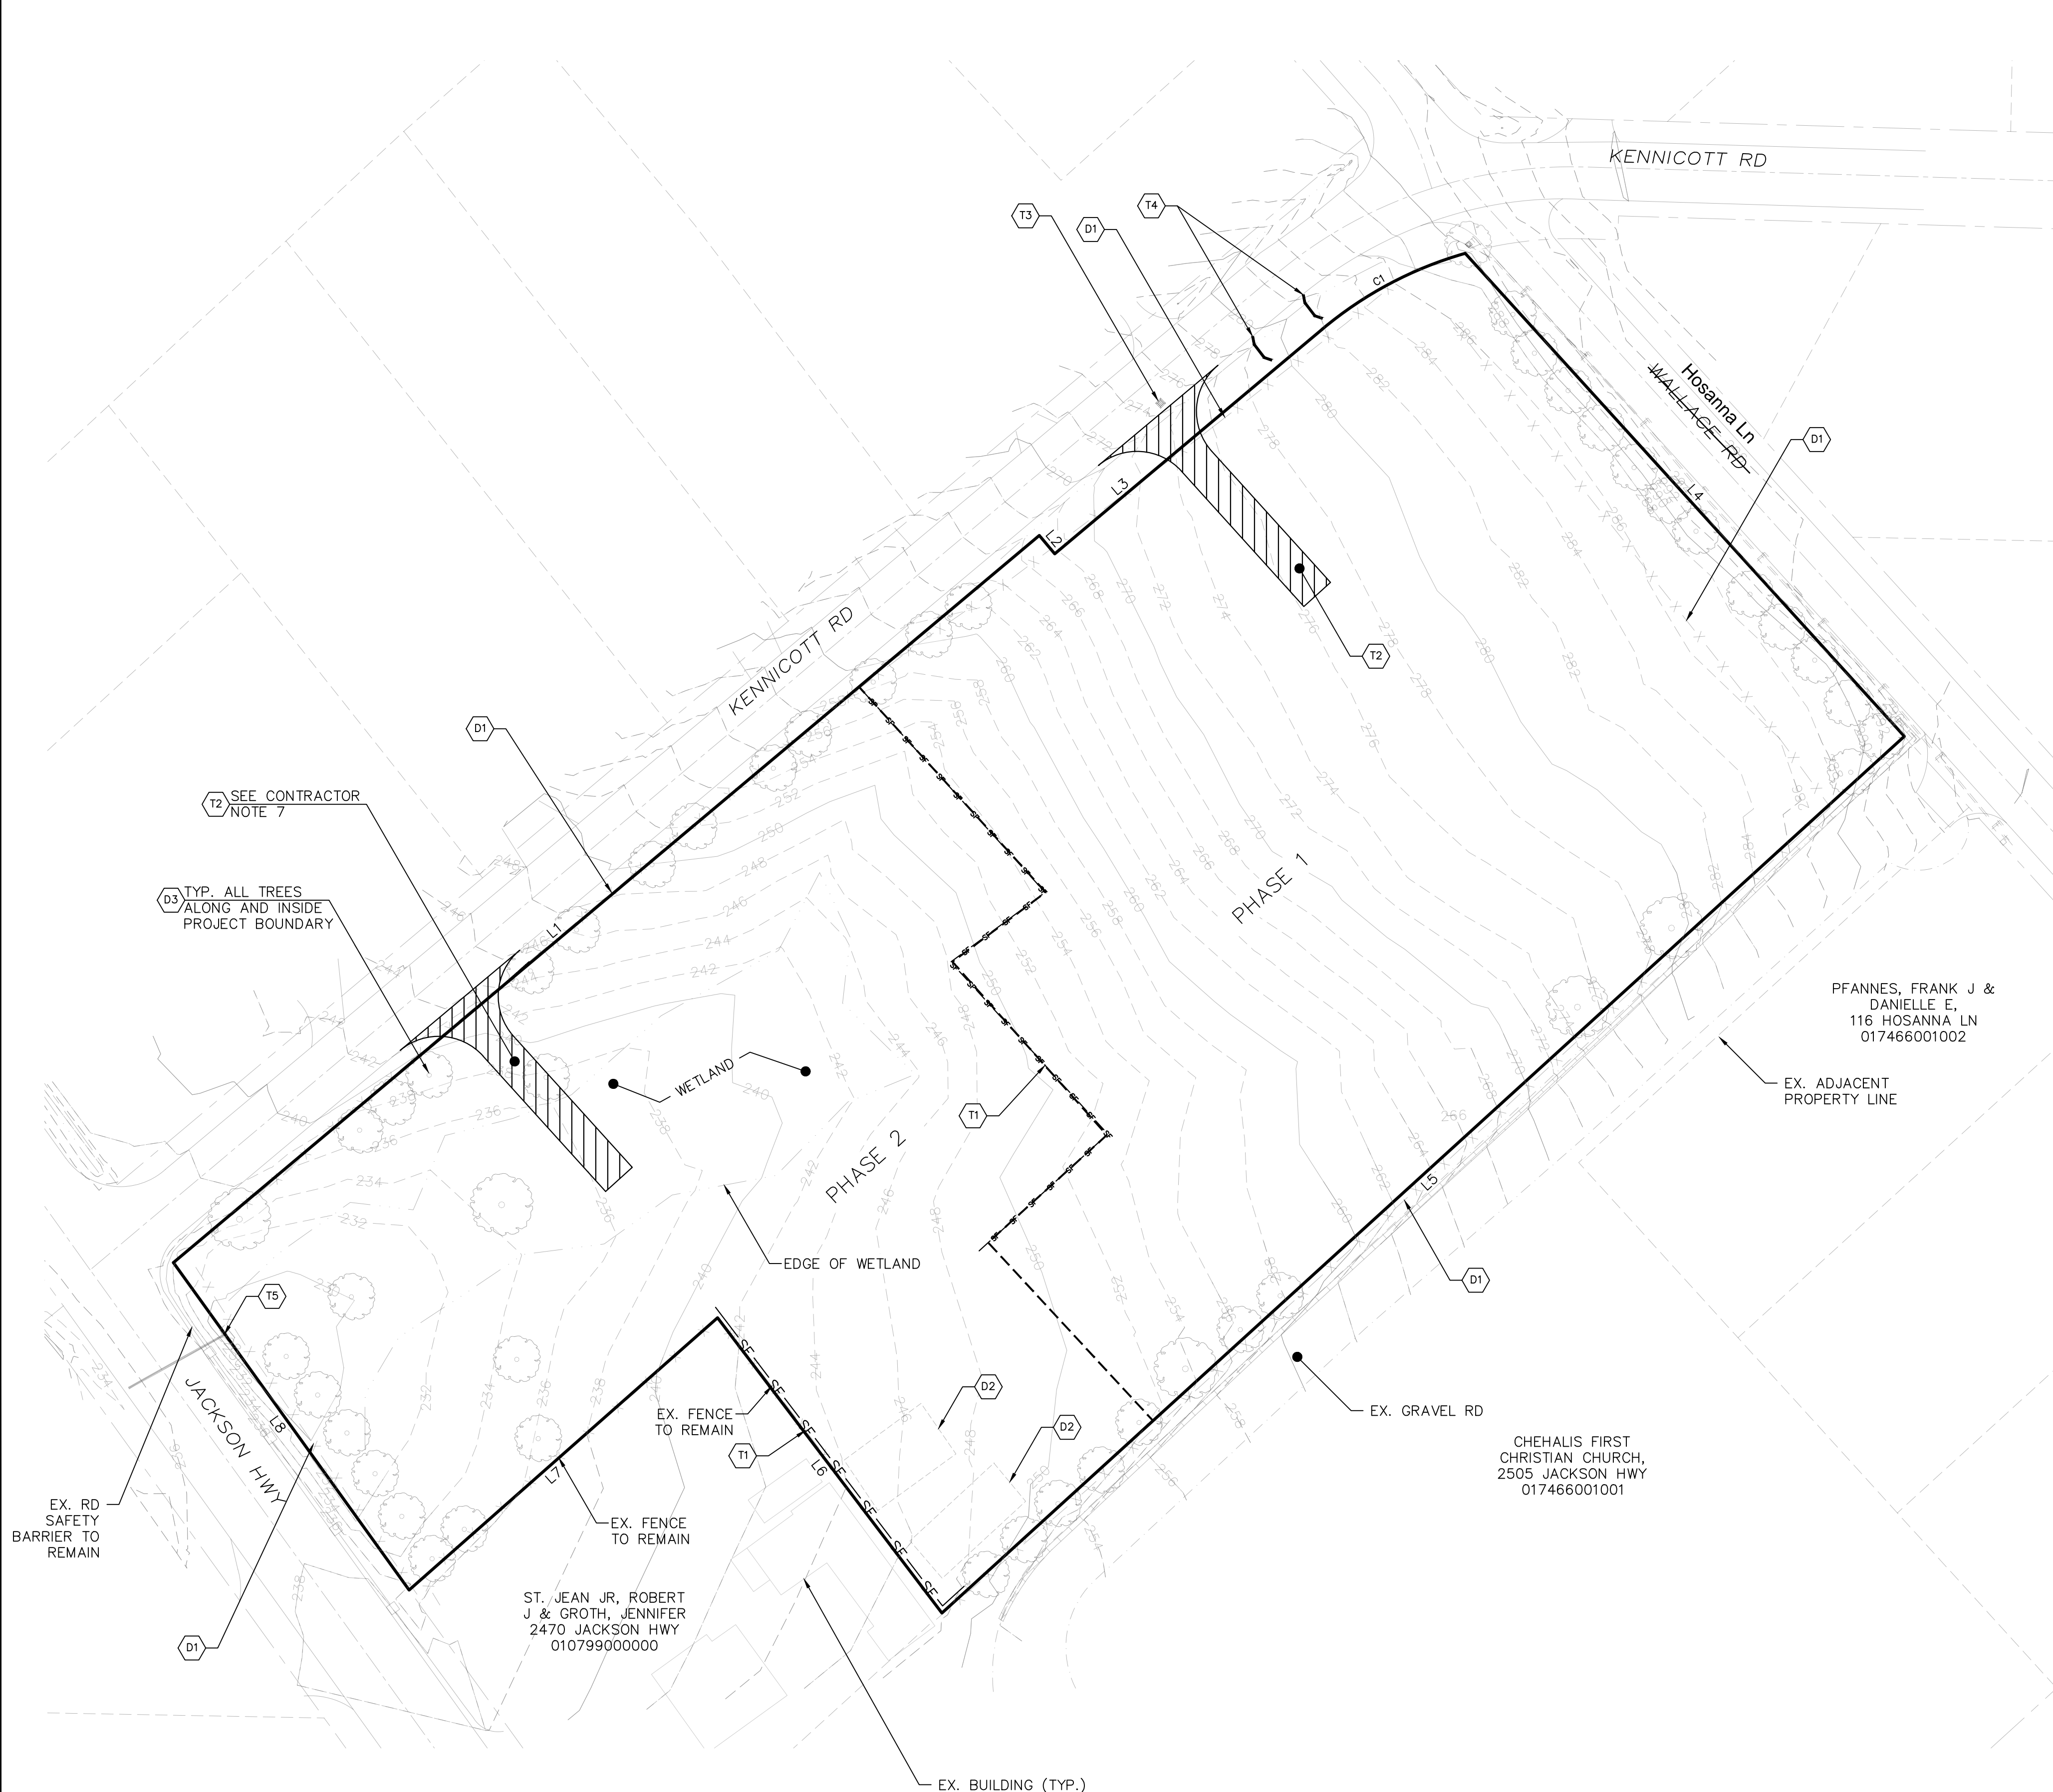

TESC NOTES:

- (T1) INSTALL SILT FENCE.
- (T2) INSTALL 100' LONG CONSTRUCTION ENTRANCE.
- (T3) INSTALL INLET PROTECTION TO EX CATCH BASIN.
- (T4) INSTALL STRAW BALE BARRIER AS SHOWN. BALES TO BE INSTALLED ALONG EXISTING DITCH SHOWN ON THIS SHEET. BALES WILL BE REMOVED ONCE SITE IS STABILIZED.
- (T5) INSTALL TWO LAYERS OF WATTLES AND A SWATH OF SILT FENCE AROUND THE INLET FOR CULVERT INLET PROTECTION.

DEMOLITION NOTES:

- (D1) EX. FENCE TO BE REMOVED.
- (D2) EX. STRUCTURE TO BE REMOVED.
- (D3) EX. TREE TO BE REMOVED.

NOTES TO CONTRACTOR:

1. ALL EXPOSED SOIL SURFACES SHALL BE SEEDED WITH AN EROSION CONTROL SEED MIX OR HYDROSEEDING IF NOT WORKED WITHIN 7 CALENDAR DAYS FROM MAY 1 TO SEPTEMBER 30. SOIL SHALL BE COVERED WITHIN 2 DAYS FROM OCTOBER 1 TO APRIL 30.
2. SEEDED AREAS WILL BE COVERED WITH MULCH, HAY OR OTHER PROTECTIVE COVERING APPROVED BY THE ENGINEER TO PREVENT WASHOUT DURING RAIN EVENTS.
3. CONTRACTOR SHALL APPLY WATER TO GRAVEL SURFACES DURING CONSTRUCTION TO MINIMIZE FUGITIVE DUST.
4. ROUTINE INSPECTION AND MAINTENANCE OF ALL INSTALLED EROSION AND SEDIMENT CONTROL BMPs, ESPECIALLY AFTER STORMS, IS REQUIRED.
5. PERIODIC STREET CLEANING MAY BE NECESSARY TO REMOVE ANY SEDIMENT TRACKED OFF THE SITE.
6. IN THE EVENT PROPOSED BMPs FAIL, APPROPRIATE MEASURES MUST BE TAKEN TO STOP SEDIMENTS FROM ENTERING WATERWAYS.
7. NO CONSTRUCTION OR DEMOLITION WILL BE ALLOWED IN PHASE 2 AREA UNTIL STATE AUTHORIZATION.

LINE TABLE		
Line #	Bearing	Length
L1	S49° 58' 51.00"W	472.03
L2	N40° 01' 09.00"W	10.00
L3	S49° 58' 51.00"W	145.84
L4	N42° 17' 06.00"W	272.52
L5	N47° 40' 14.69"E	543.52
L6	N37° 13' 46.00"W	154.81
L7	N48° 33' 44.00"E	171.73
L8	S35° 44' 51.00"E	168.43

CURVE TABLE		
Curve #	Radius	Length
C1	161.44	68.03

DRAWING TITLE: **EX. CONDITION, DEMO AND TESC PLAN**

SCALE: **1:40**

DATE: **02/22/21**

CHECKED: **AF**

DRAWN: **SD**

PROJECT NAME: **JACKSON VILLA 4**

03/11/2021



Exp: 12/21/2022

FULLER DESIGNS
 1101 KRESKY AVE
 CENTRALIA, WA 98531
 (360) 807-4420

REV.	DESCRIPTION	DATE
0	PRELIMINARY - FOR PERMIT	02/22/21
1		

PRELIMINARY
FOR PERMIT ONLY

SECTION 03 TOWNSHIP 13N RANGE 02W

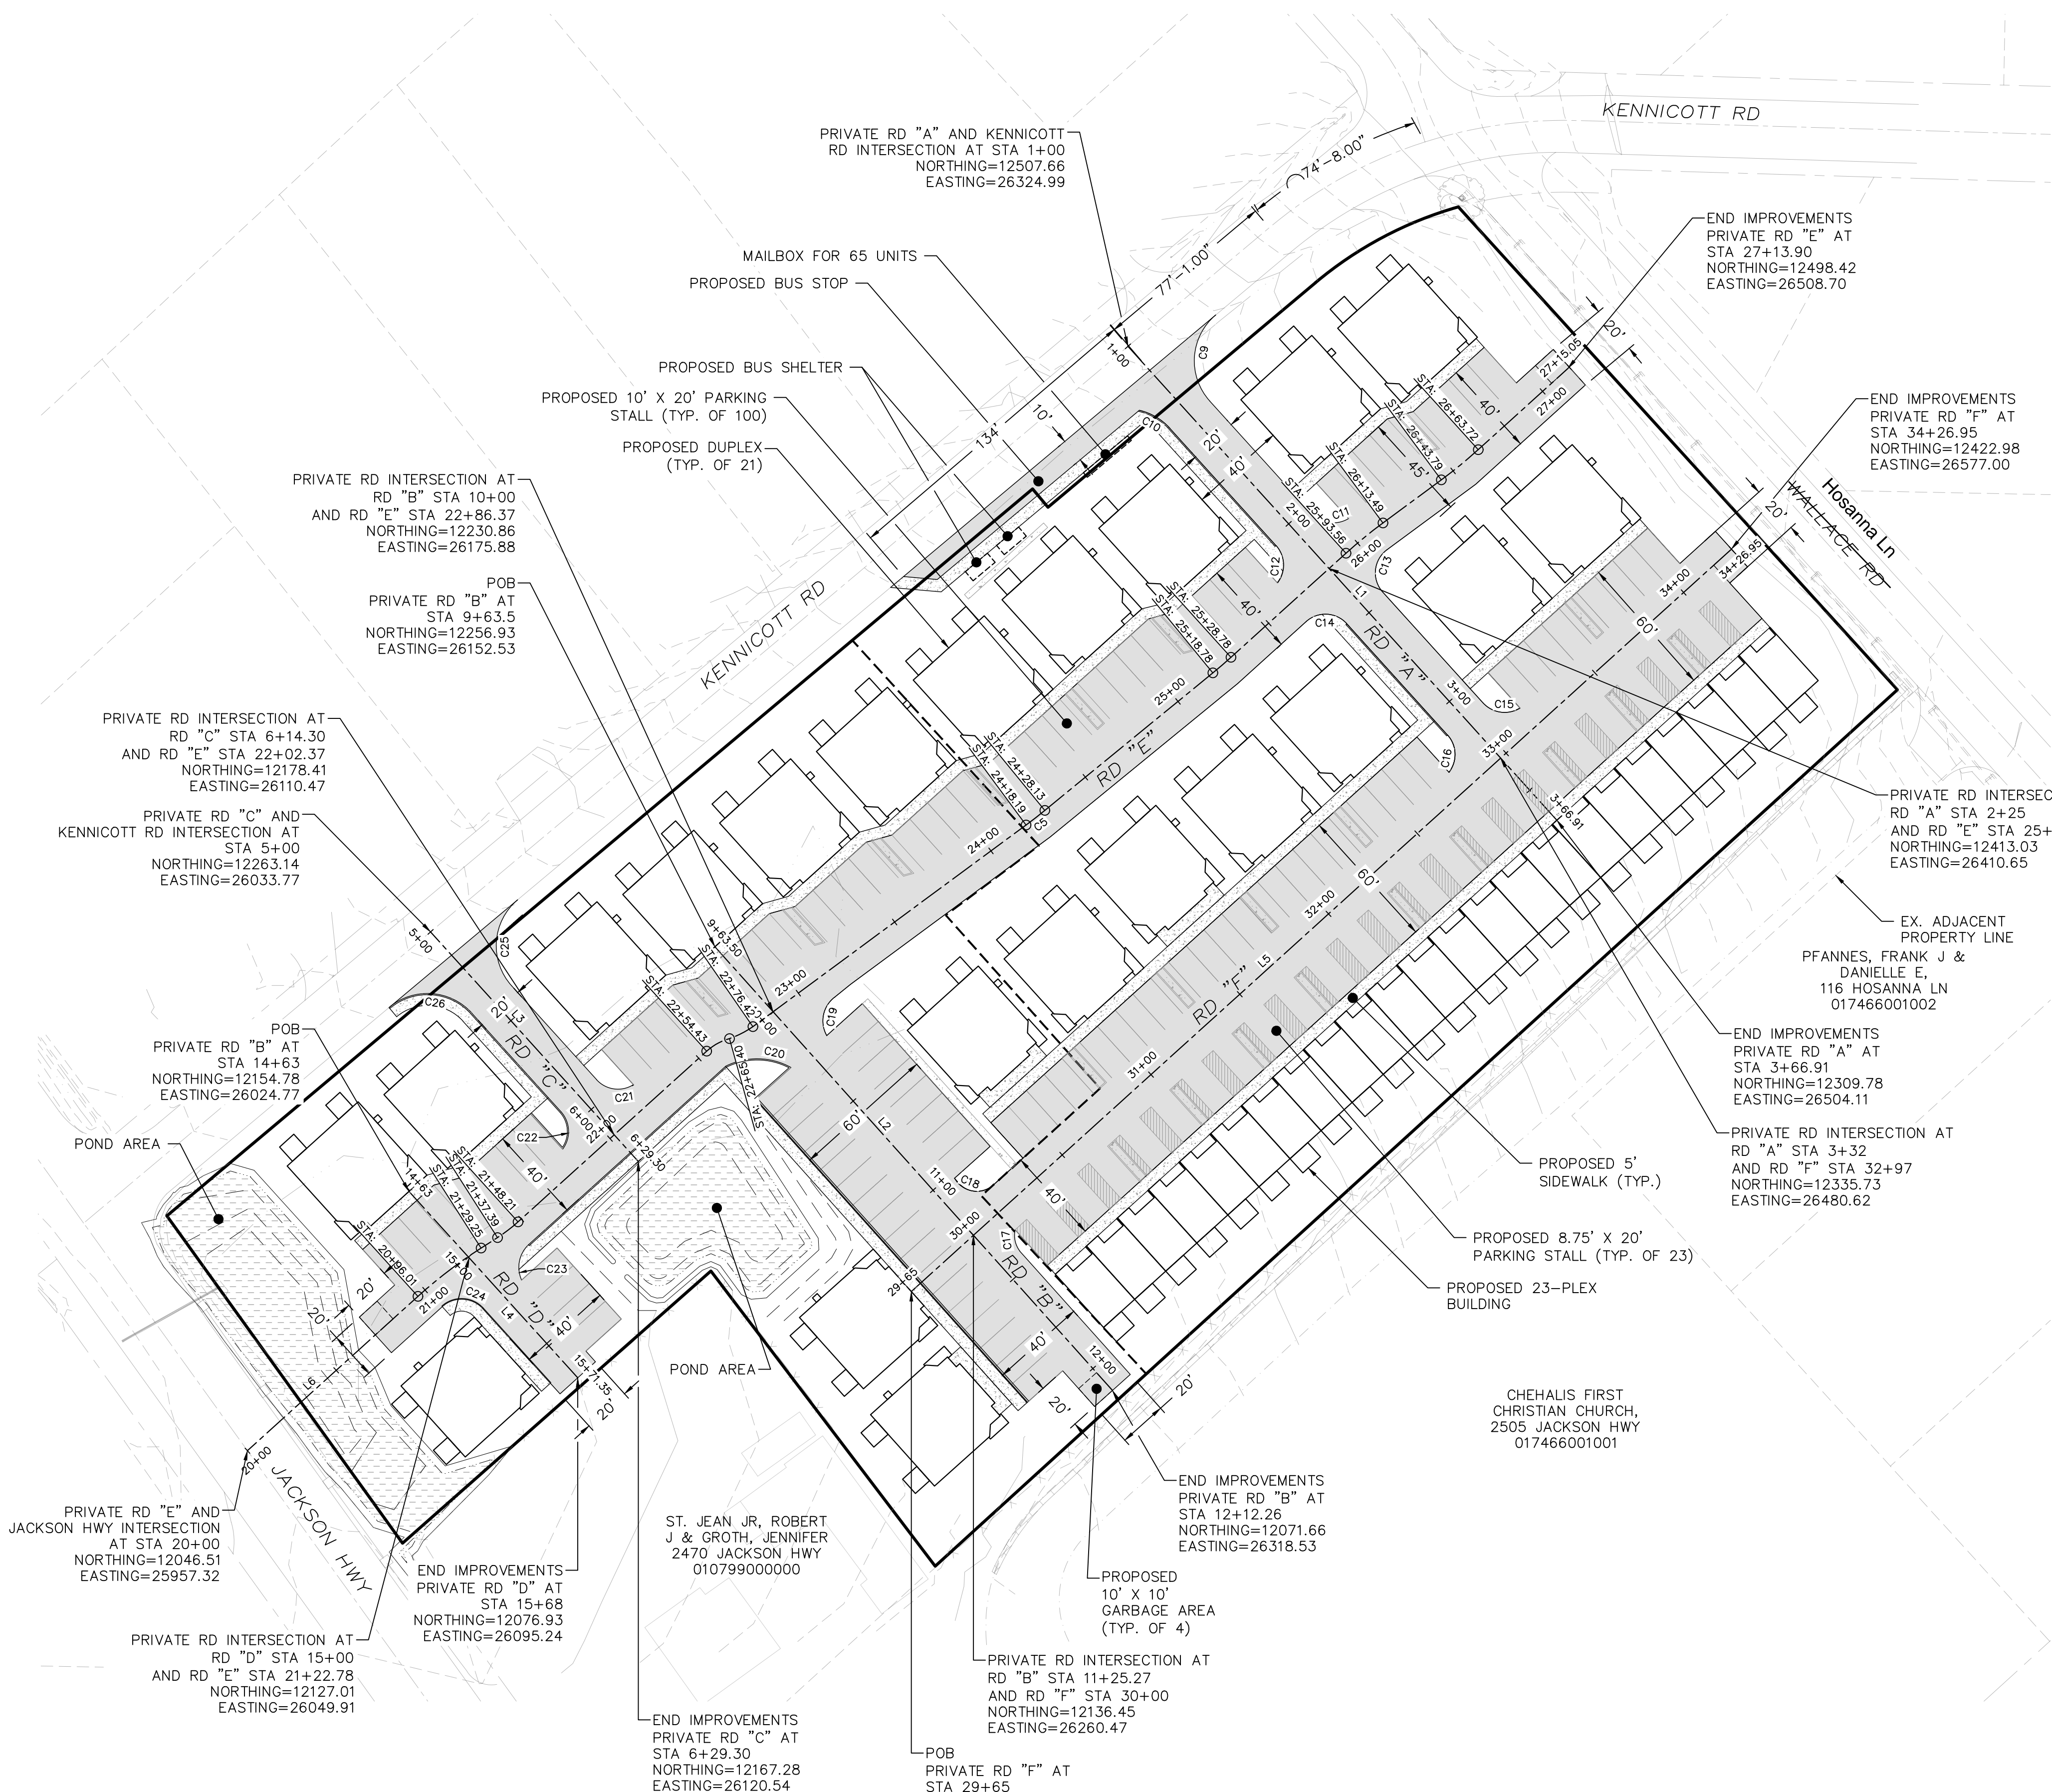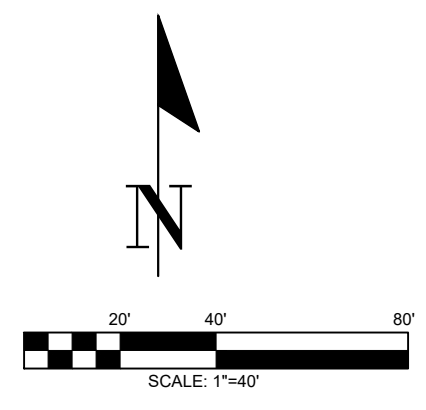

LINE TABLE

Line #	Bearing	Length
L1	S42° 09' 06.82"E	266.91
L2	S41° 51' 35.42"E	248.76
L3	S42° 09' 06.82"E	129.30
L4	N42° 09' 06.33"W	105.00
L5	N47° 50' 53.18"E	461.95
L6	N47° 50' 53.18"E	96.01

CURVE TABLE

Curve #	Radius	Length
C5	200.00	9.94
C9	25.00	40.23
C10	25.00	15.13
C11	12.36	16.91
C12	12.00	16.84
C13	12.00	20.05
C14	12.00	18.85
C15	12.00	16.84
C16	12.00	16.84
C17	10.75	9.46
C18	10.53	18.73
C19	12.44	17.83
C20	29.28	28.42

CURVE TABLE

Curve #	Radius	Length
C21	12.00	16.84
C22	12.36	16.91
C23	12.92	16.00
C24	12.00	18.85
C25	25.00	40.23
C26	25.00	38.31

DRAWING TITLE: HORIZONTAL CONTROL PLAN

SCALE: 1:40

DATE: 02/22/21

DRAWN: SD

CHECKED: AF

PROJECT NAME: JACKSON VILLA 4

03/11/2021

Exp: 12/21/2022

FULLER DESIGNS

1101 KRESKY AVE



CENTRALIA, WA 98531

(360) 807-4420


REV.	DESCRIPTION	DATE
0	PRELIMINARY - FOR PERMIT	02/22/21

PRELIMINARY
FOR PERMIT ONLY

SECTION 03 TOWNSHIP 13N RANGE 02W

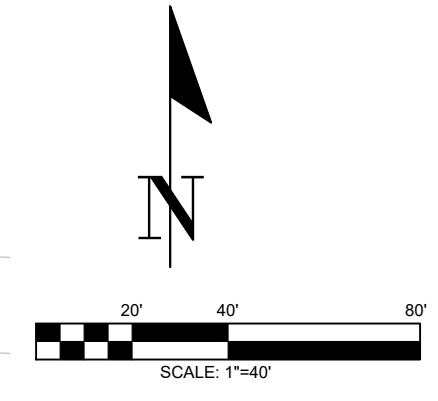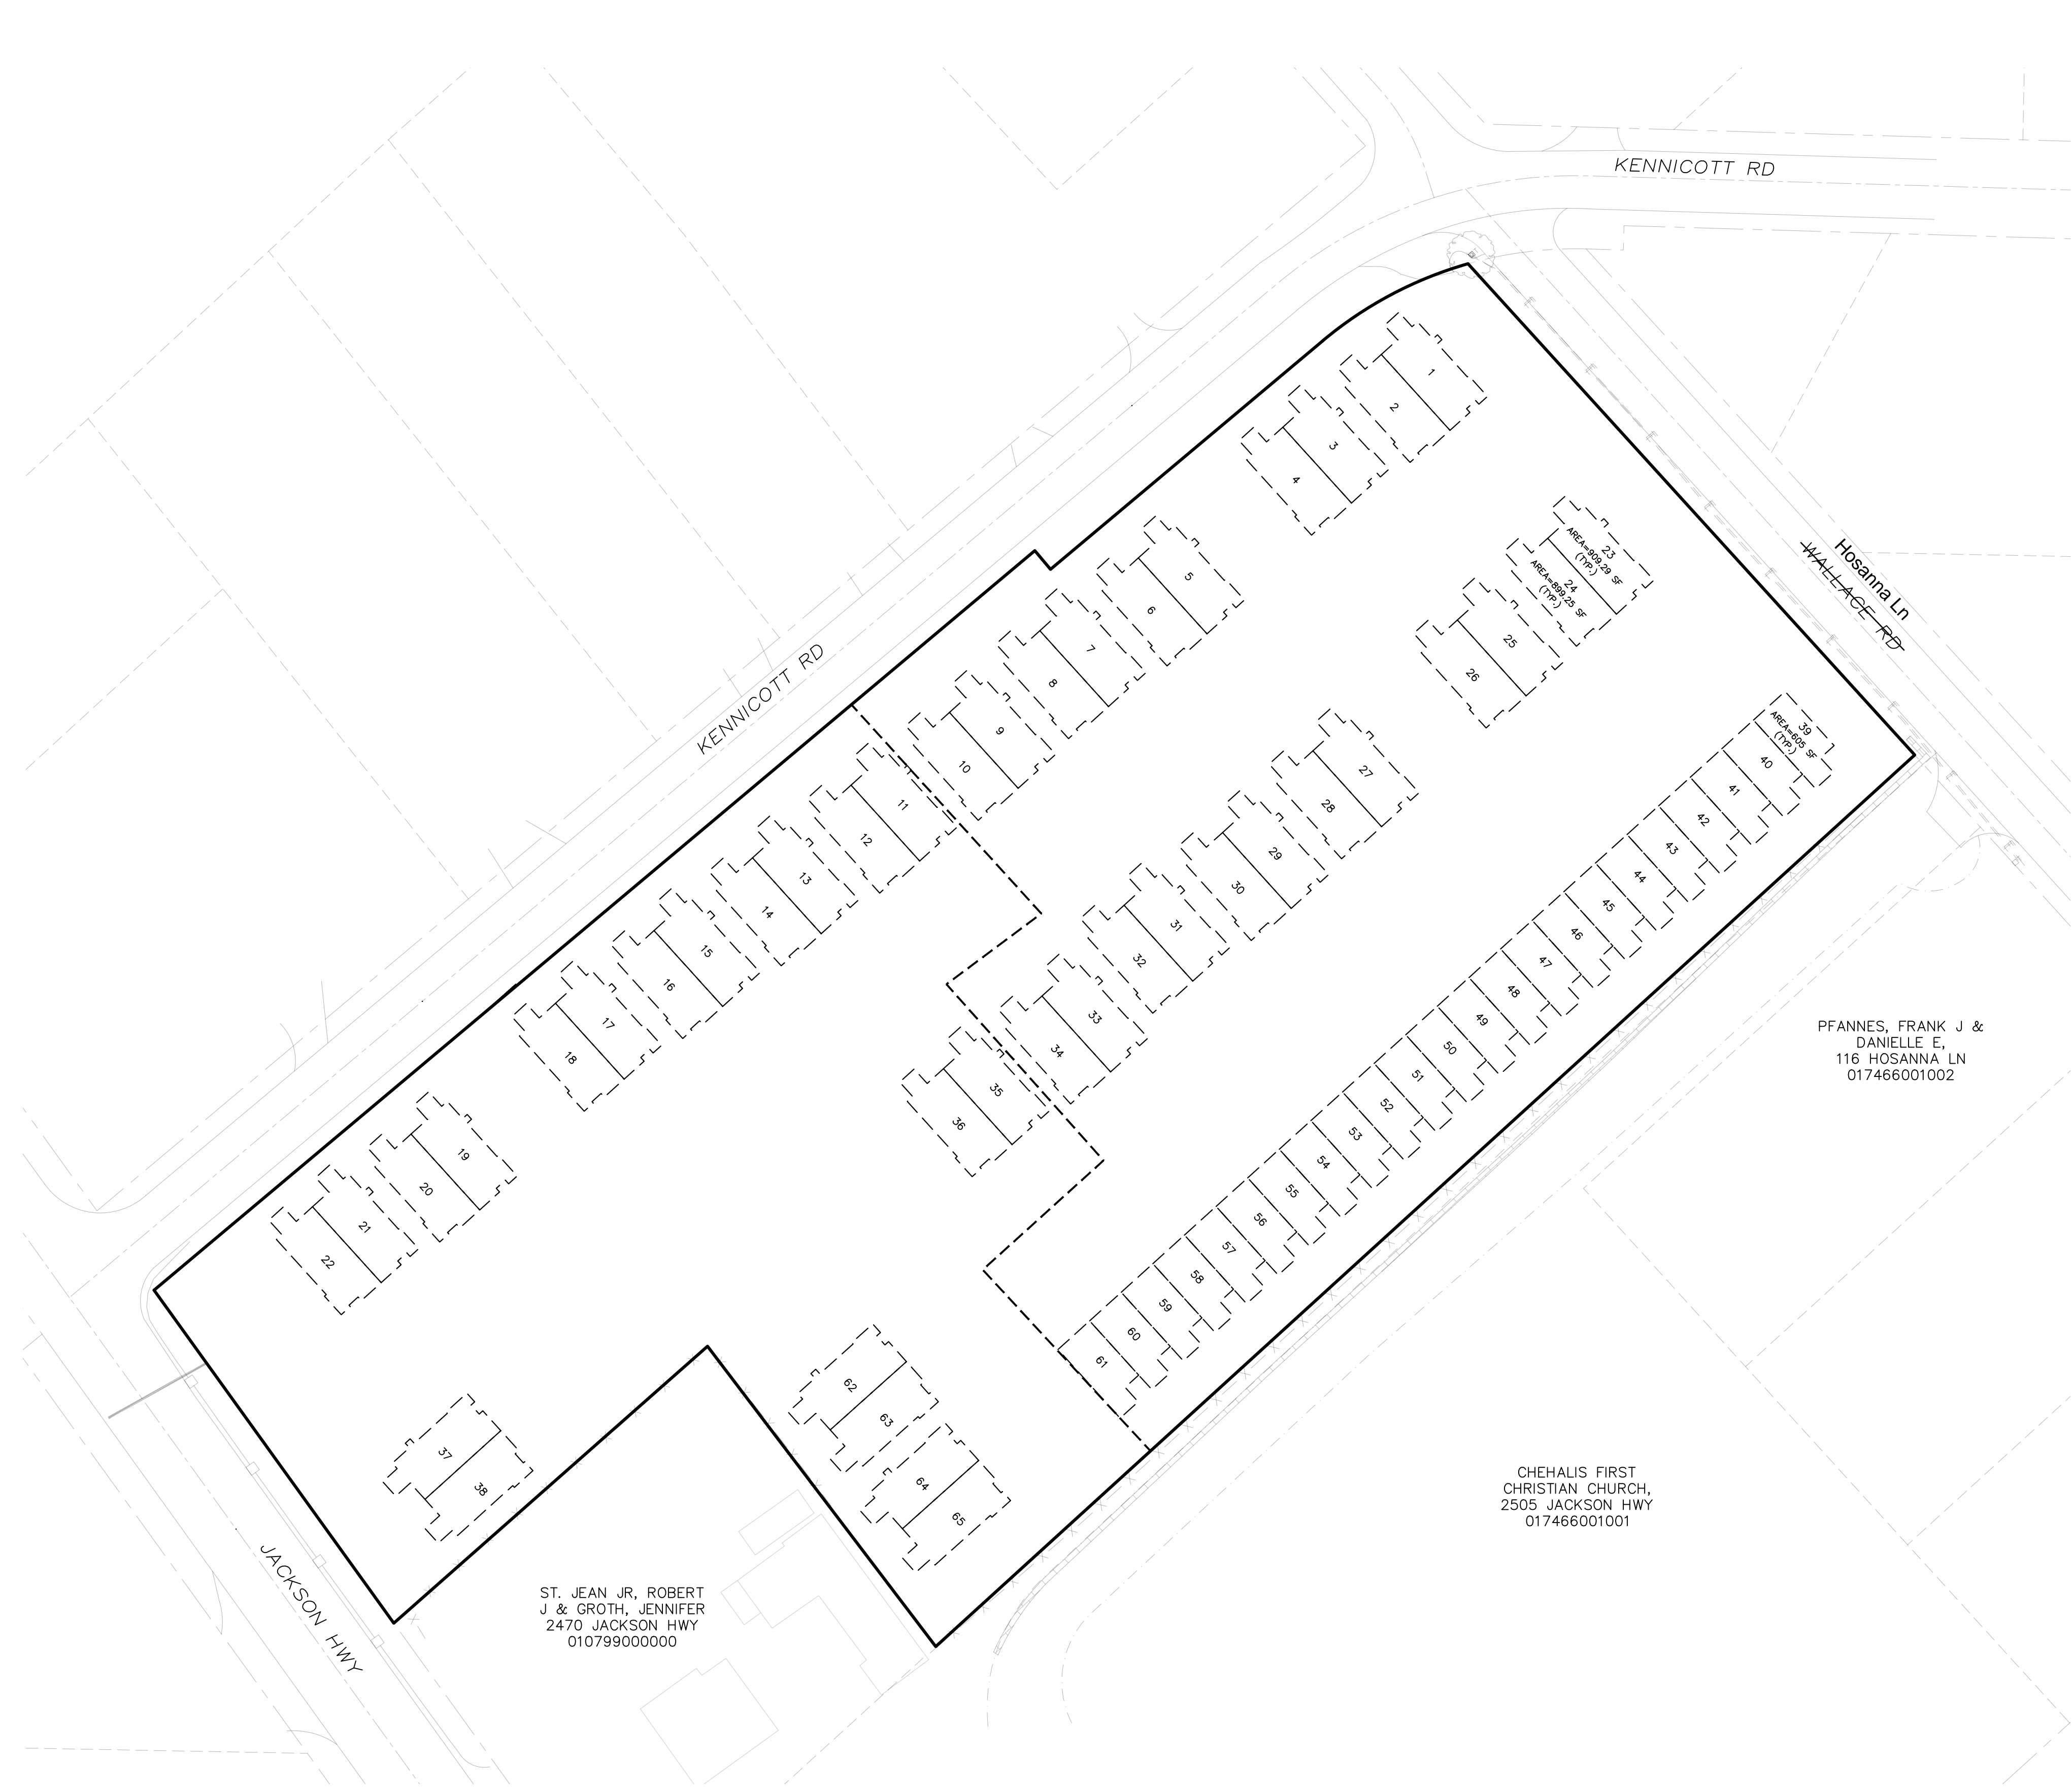

DRAWING TITLE: LOT LAYOUT			
SCALE: 1:40	DATE: 02/22/21	DRAWN: SD	CHECKED: AF
PROJECT NAME: JACKSON VILLA 4			

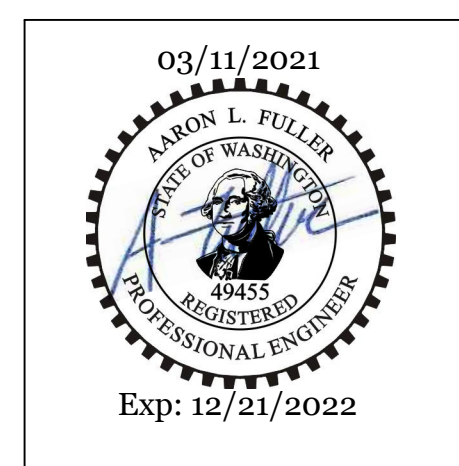

FULLER DESIGNS
 1101 KRESKY AVE
 CENTRALIA, WA 98531
 (360) 807-4420





REV.	DESCRIPTION	DATE
0	PRELIMINARY - FOR PERMIT	02/22/21
1		

PRELIMINARY
FOR PERMIT ONLY

C2.2
4 OF 8

SECTION 03 TOWNSHIP 13N RANGE 02W

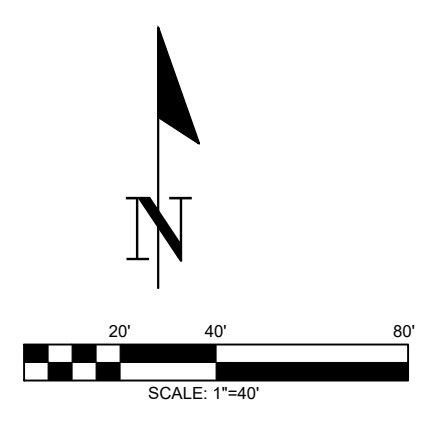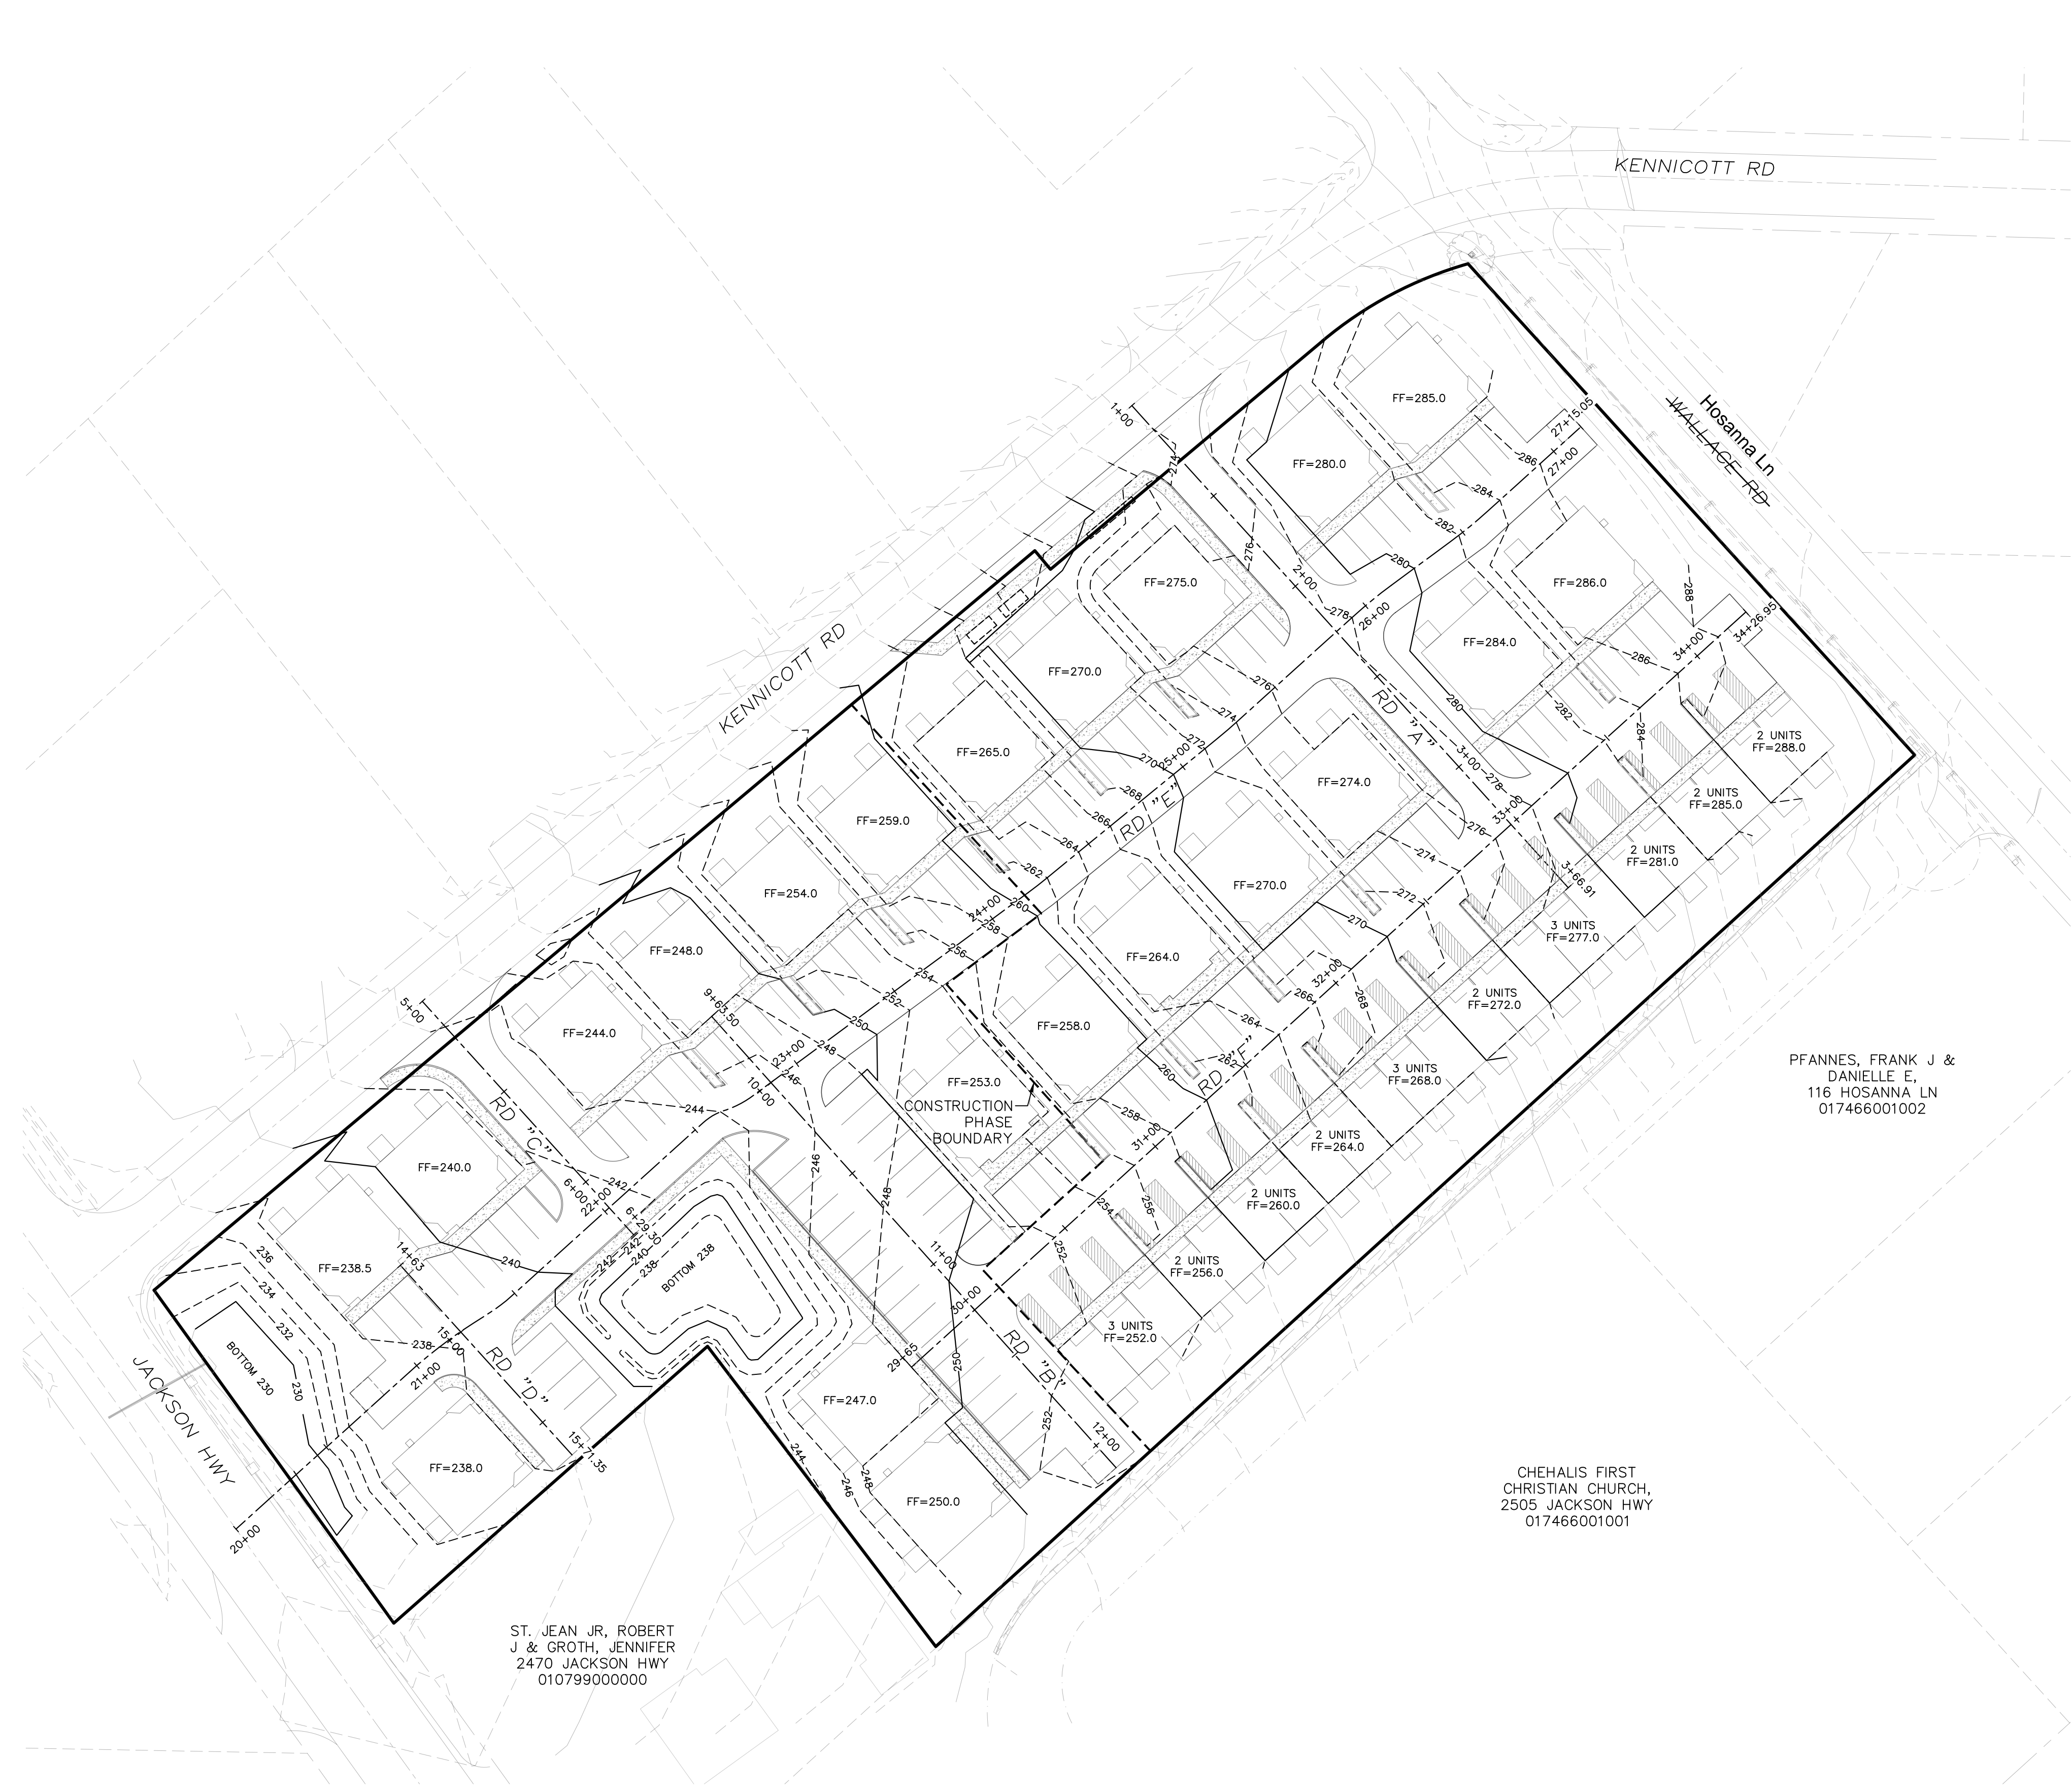

ST. JEAN JR, ROBERT
J & GROTH, JENNIFER
2470 JACKSON HWY
010799000000

PFANNES, FRANK J &
DANIELLE E,
116 HOSANNA LN
017466001002

CHEHALIS FIRST
CHRISTIAN CHURCH,
2505 JACKSON HWY
017466001001

DRAWING TITLE: OVERALL GRADING PLAN			
SCALE: 1:40	DATE: 02/22/21	DRAWN: SD	CHECKED: AF
PROJECT NAME: JACKSON VILLA 4			





FULLER DESIGNS
1101 KRESKY AVE
CENTRALIA, WA 98531
(360) 807-4420

REV.	DESCRIPTION	DATE
0	PRELIMINARY - FOR PERMIT	02/22/21
1		

PRELIMINARY
FOR PERMIT ONLY


SECTION 03 TOWNSHIP 13N RANGE 02W

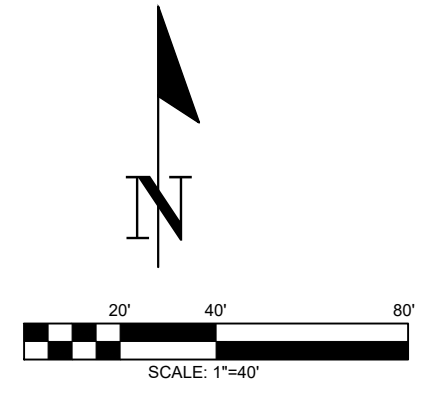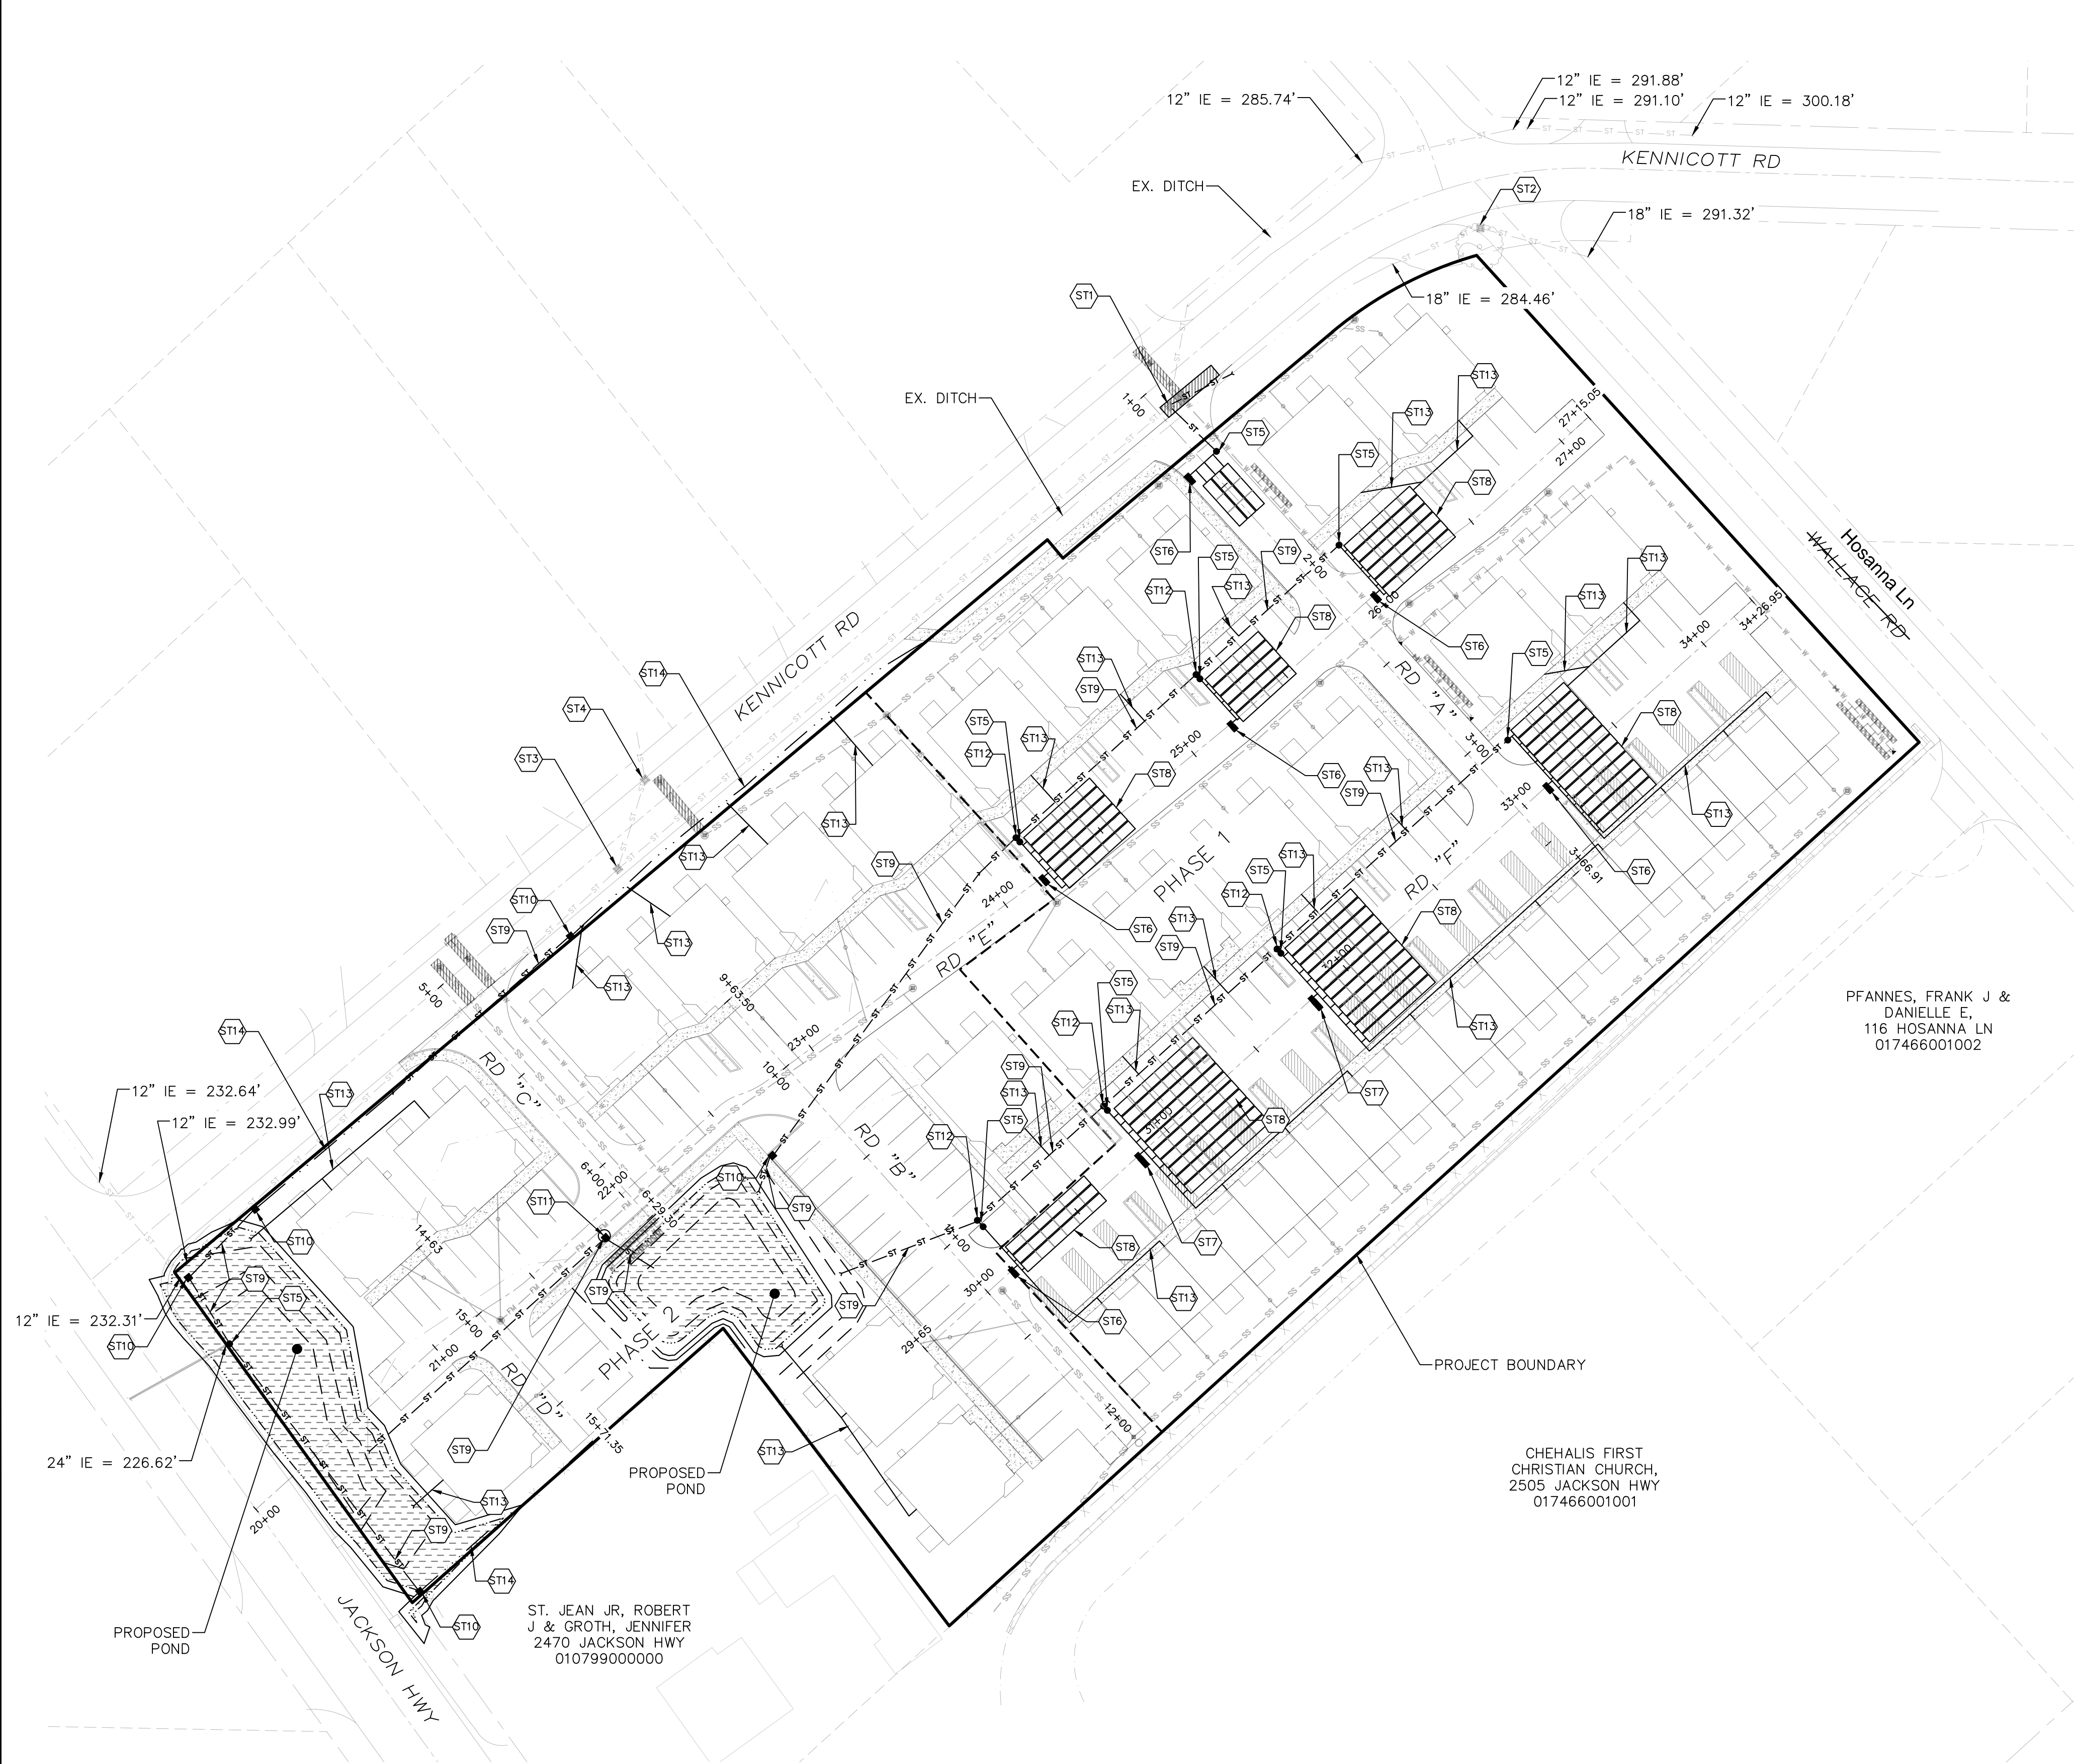

STORMWATER NOTES:

- ST1 EX. CB#1
RIM = 274.65
IN 12" IE = 272.7 (N)
OUT 12" IE=272.45 (SW)
- ST2 EX. CB#2
RIM = 291.72
IN 18" IE = 287.99 (SE)
OUT 18" IE=288.06 (SW)
- ST3 EX. CB#3
RIM = 250.17
IN 8" IE = 247.67 (N)
IN 12" IE = 247.62 (NE)
OUT 12" IE=247.47 (SW)
- ST4 EX. CB#4
RIM = 252.73
IN 6" IE = 250.93 (S)
OUT 8" IE = 250.38 (N)
- ST5 INSTALL SOLID LID CONTROL STRUCTURE (TYP OF 9)
- ST6 INSTALL CB CONTECH 1 CARTRIDGE STORMFILTER (TYP OF 6)
- ST7 INSTALL CB CONTECH 2 CARTRIDGE STORMFILTER (TYP OF 2)
- ST8 INSTALL CONTECH CHAMBERMAXX STORMWATER RETENTION SYSTEM
- ST9 INSTALL STORM PIPE
- ST10 INSTALL CB TYPE 1 (TYP OF 5)
- ST11 INSTALL CB GRATE LID TYPE 2 (TYP OF 1)
- ST12 INSTALL CB SOLID LID TYPE 2 (TYP OF 5)
- ST13 INSTALL DRAIN PIPE
- ST14 INSTALL BIOSWALE DITCH

DRAWING TITLE: FULL SITE STORM DRAINAGE PLAN		CHECKED: AF
SCALE: 1:40	DATE: 02/22/21	DRAWN: SD
PROJECT NAME: JACKSON VILLA 4		

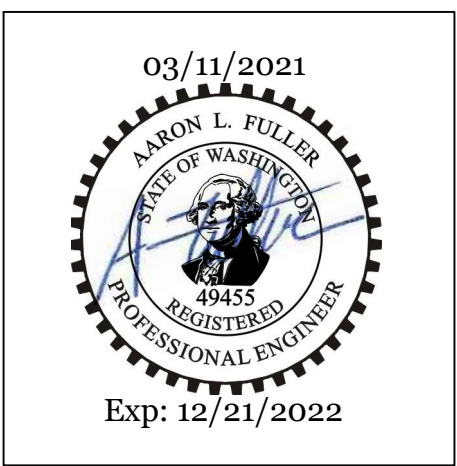

FULLER DESIGNS
1101 KRESKY AVE
CENTRALIA, WA 98531
(360) 807-4420

REV.	DESCRIPTION	DATE
0	PRELIMINARY - FOR PERMIT	02/22/21
1		



ST. JEAN JR, ROBERT
J & GROTH, JENNIFER
2470 JACKSON HWY
010799000000

PFANNES, FRANK J &
DANIELLE E,
116 HOSANNA LN
017466001002

CHEHALIS FIRST
CHRISTIAN CHURCH,
2505 JACKSON HWY
017466001001

PRELIMINARY
FOR PERMIT ONLY

SECTION 03 TOWNSHIP 13N RANGE 02W

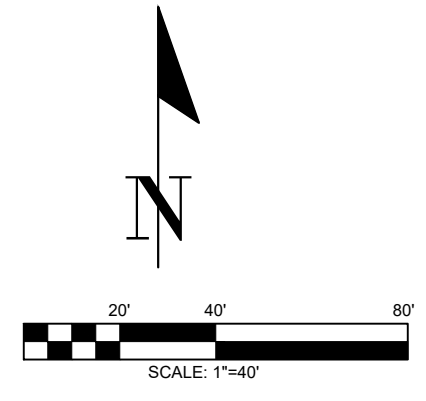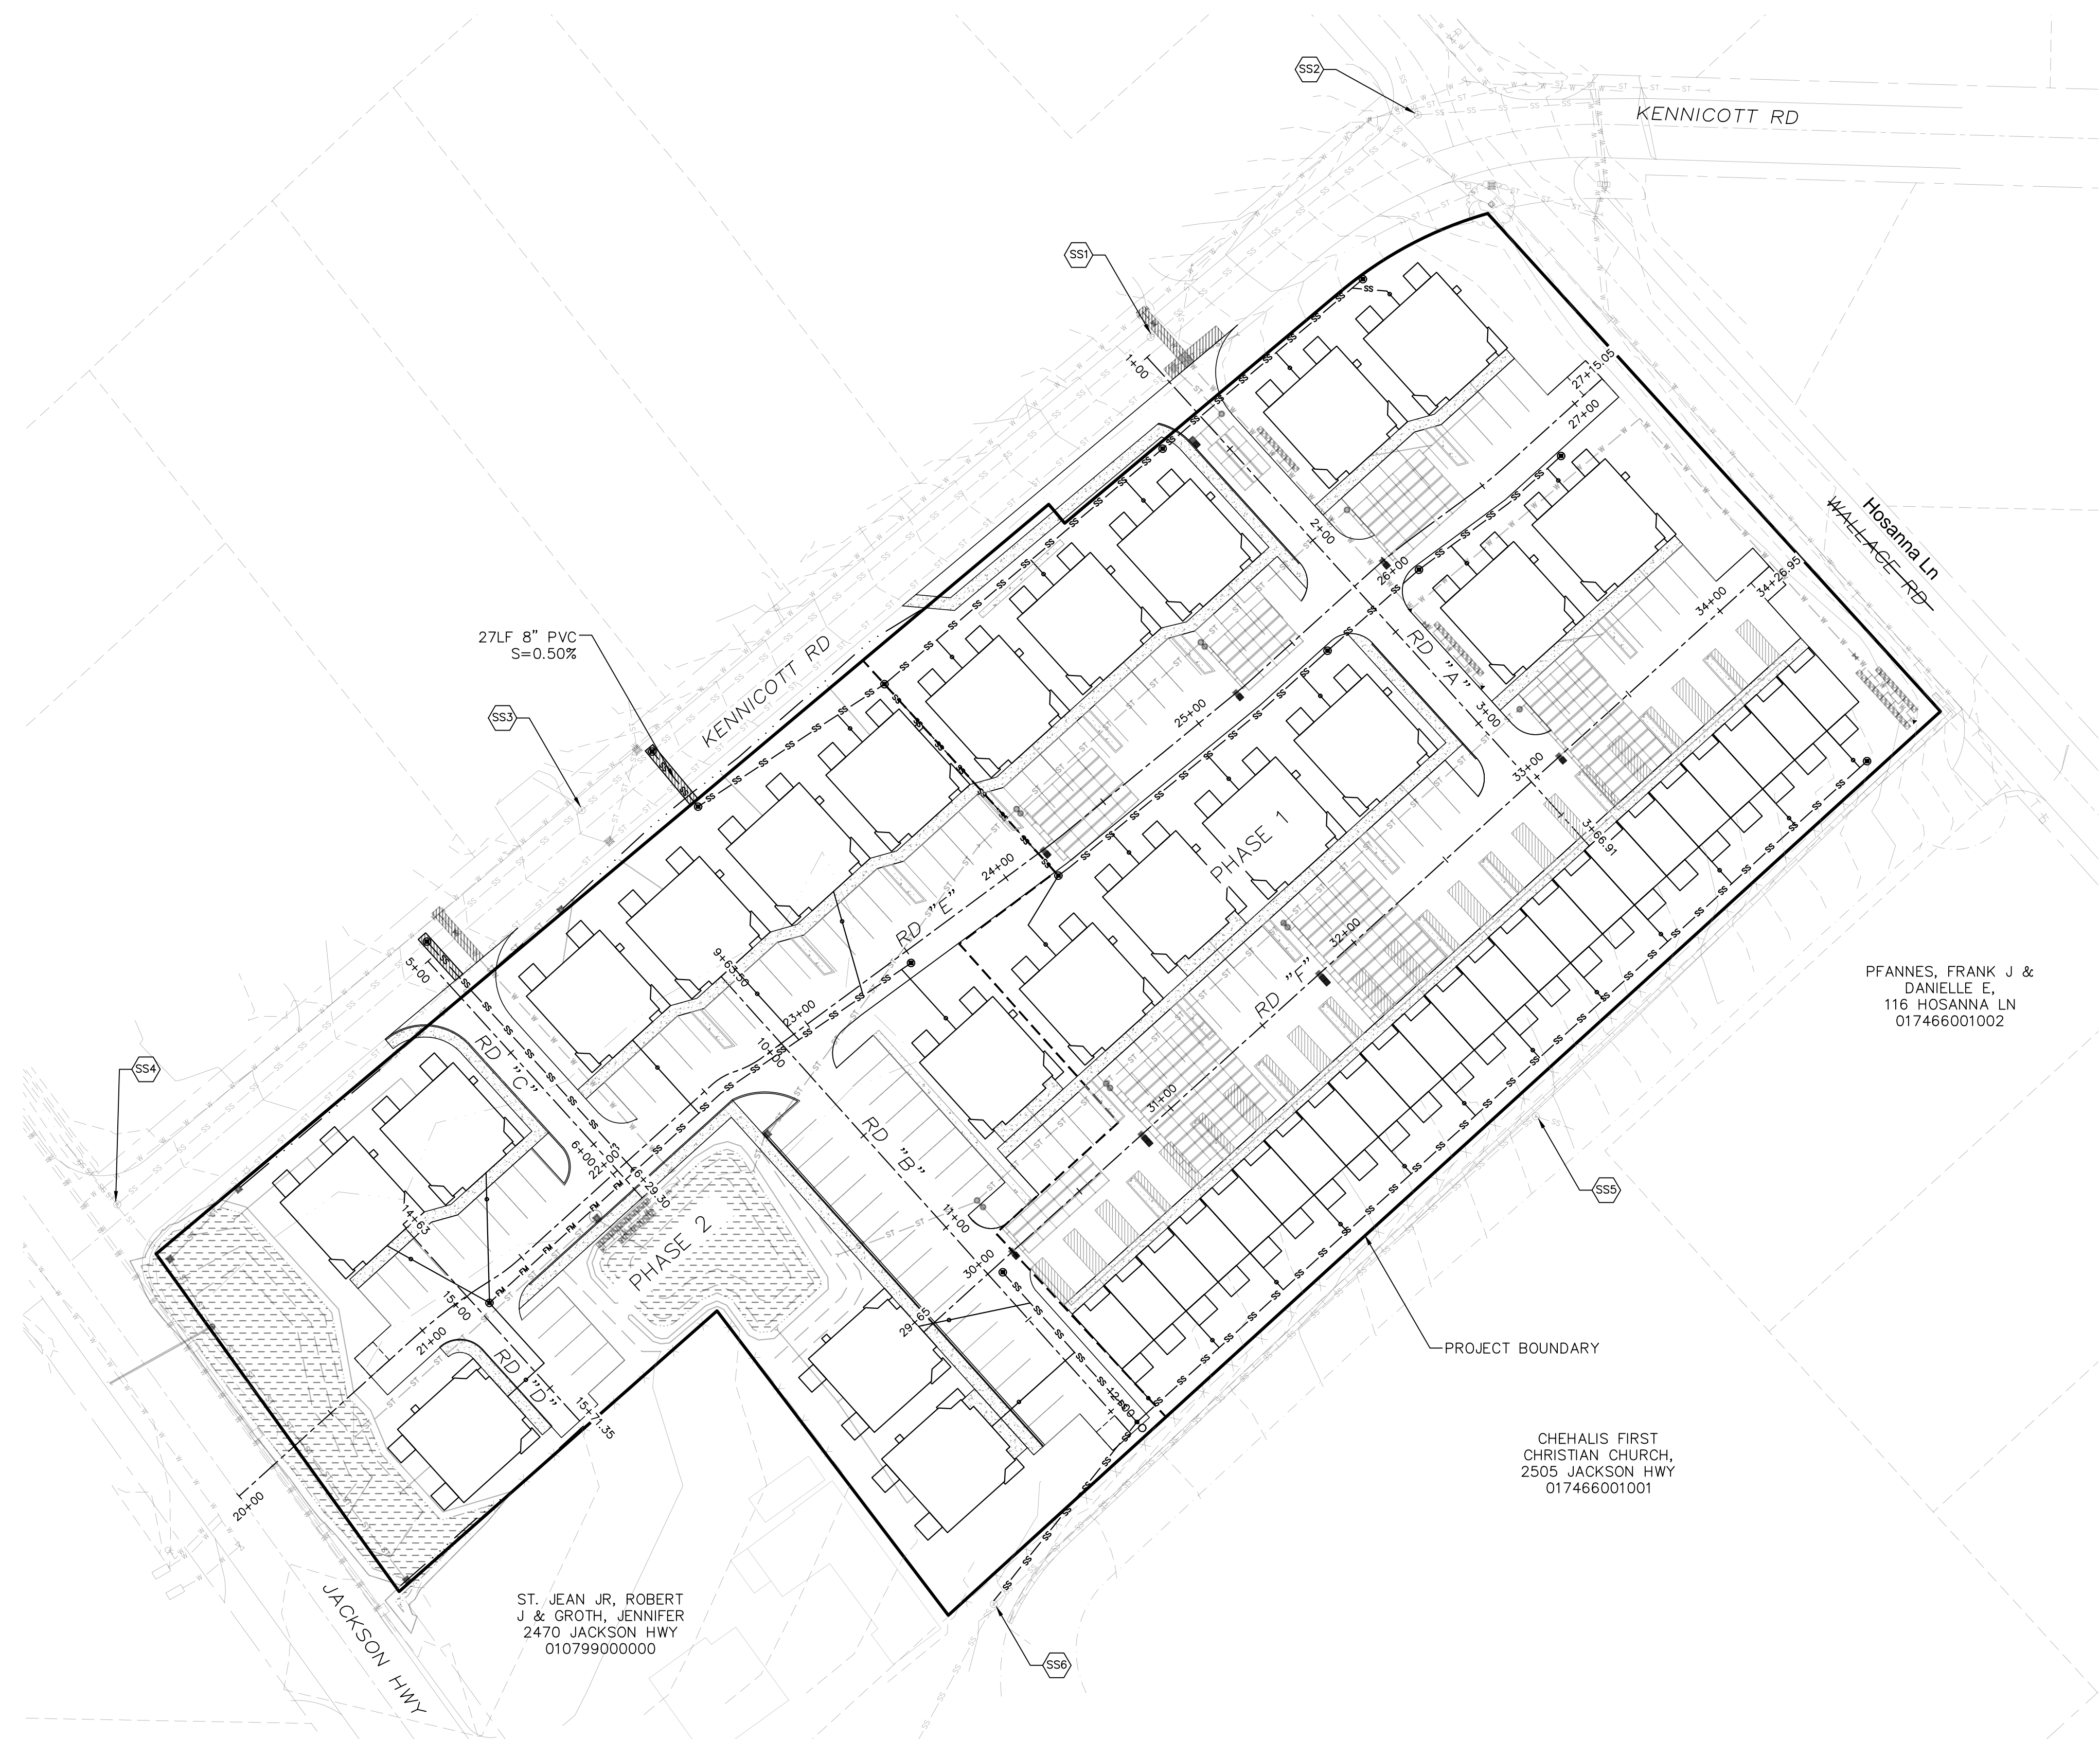

SEWER NOTES:

- SS1 EX. SSMH#1
RIM = 275.32
10" IE = 267.16 (NE)
10" IE = 267.08 (SW)
- SS2 EX. SSMH#2
RIM = 290.78
10" IE = 284.08 (NW)
6" IE = 284.16 (E)
10" IE = 283.24 (SW)
- SS3 EX. SSMH#3
RIM = 250.21
10" IE = 243.86 (NE)
10" IE = 243.67 (SW)
- SS4 EX. SSMH#4
RIM = 236.58
10" IE = 229.95 (NE)
10" IE = 229.77 (NW)
CHANNEL CAPED FL = 230.26 (SE)
- SS5 EX. SSMH#5
RIM = 270.02
8" IE = 262.42 (E)
8" IE = 262.39 (SW)
- SS6 EX. SSMH#6
RIM = 252.26
8" IE = 244.15 (NE)
8" IE = 244.05 (SW)

27LF 8" PVC
S=0.50%

SS3

KENNICOTT RD

PHASE 1

PFANNES, FRANK J &
DANIELLE E,
116 HOSANNA LN
017466001002

PROJECT BOUNDARY

CHEHALIS FIRST
CHRISTIAN CHURCH,
2505 JACKSON HWY
017466001001

ST. JEAN JR, ROBERT
J & GROTH, JENNIFER
2470 JACKSON HWY
010799000000

JACKSON HWY

Hosanna Ln
WALLACE RD

DRAWING TITLE:		FULL SITE SEWER PLAN	
SCALE:	1:40	DATE:	02/22/21
		DRAWN:	SD
		CHECKED:	AF
PROJECT NAME:		JACKSON VILLA 4	





FULLER DESIGNS
1101 KRESKY AVE
CENTRALIA, WA 98531
(360) 807-4420

REV.	DESCRIPTION:	DATE:
0	PRELIMINARY - FOR PERMIT	02/22/21
1		

PRELIMINARY
FOR PERMIT ONLY

C5.1
7 OF 8

SECTION 03 TOWNSHIP 13N RANGE 02W

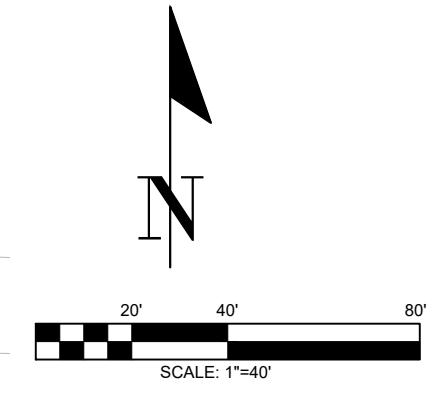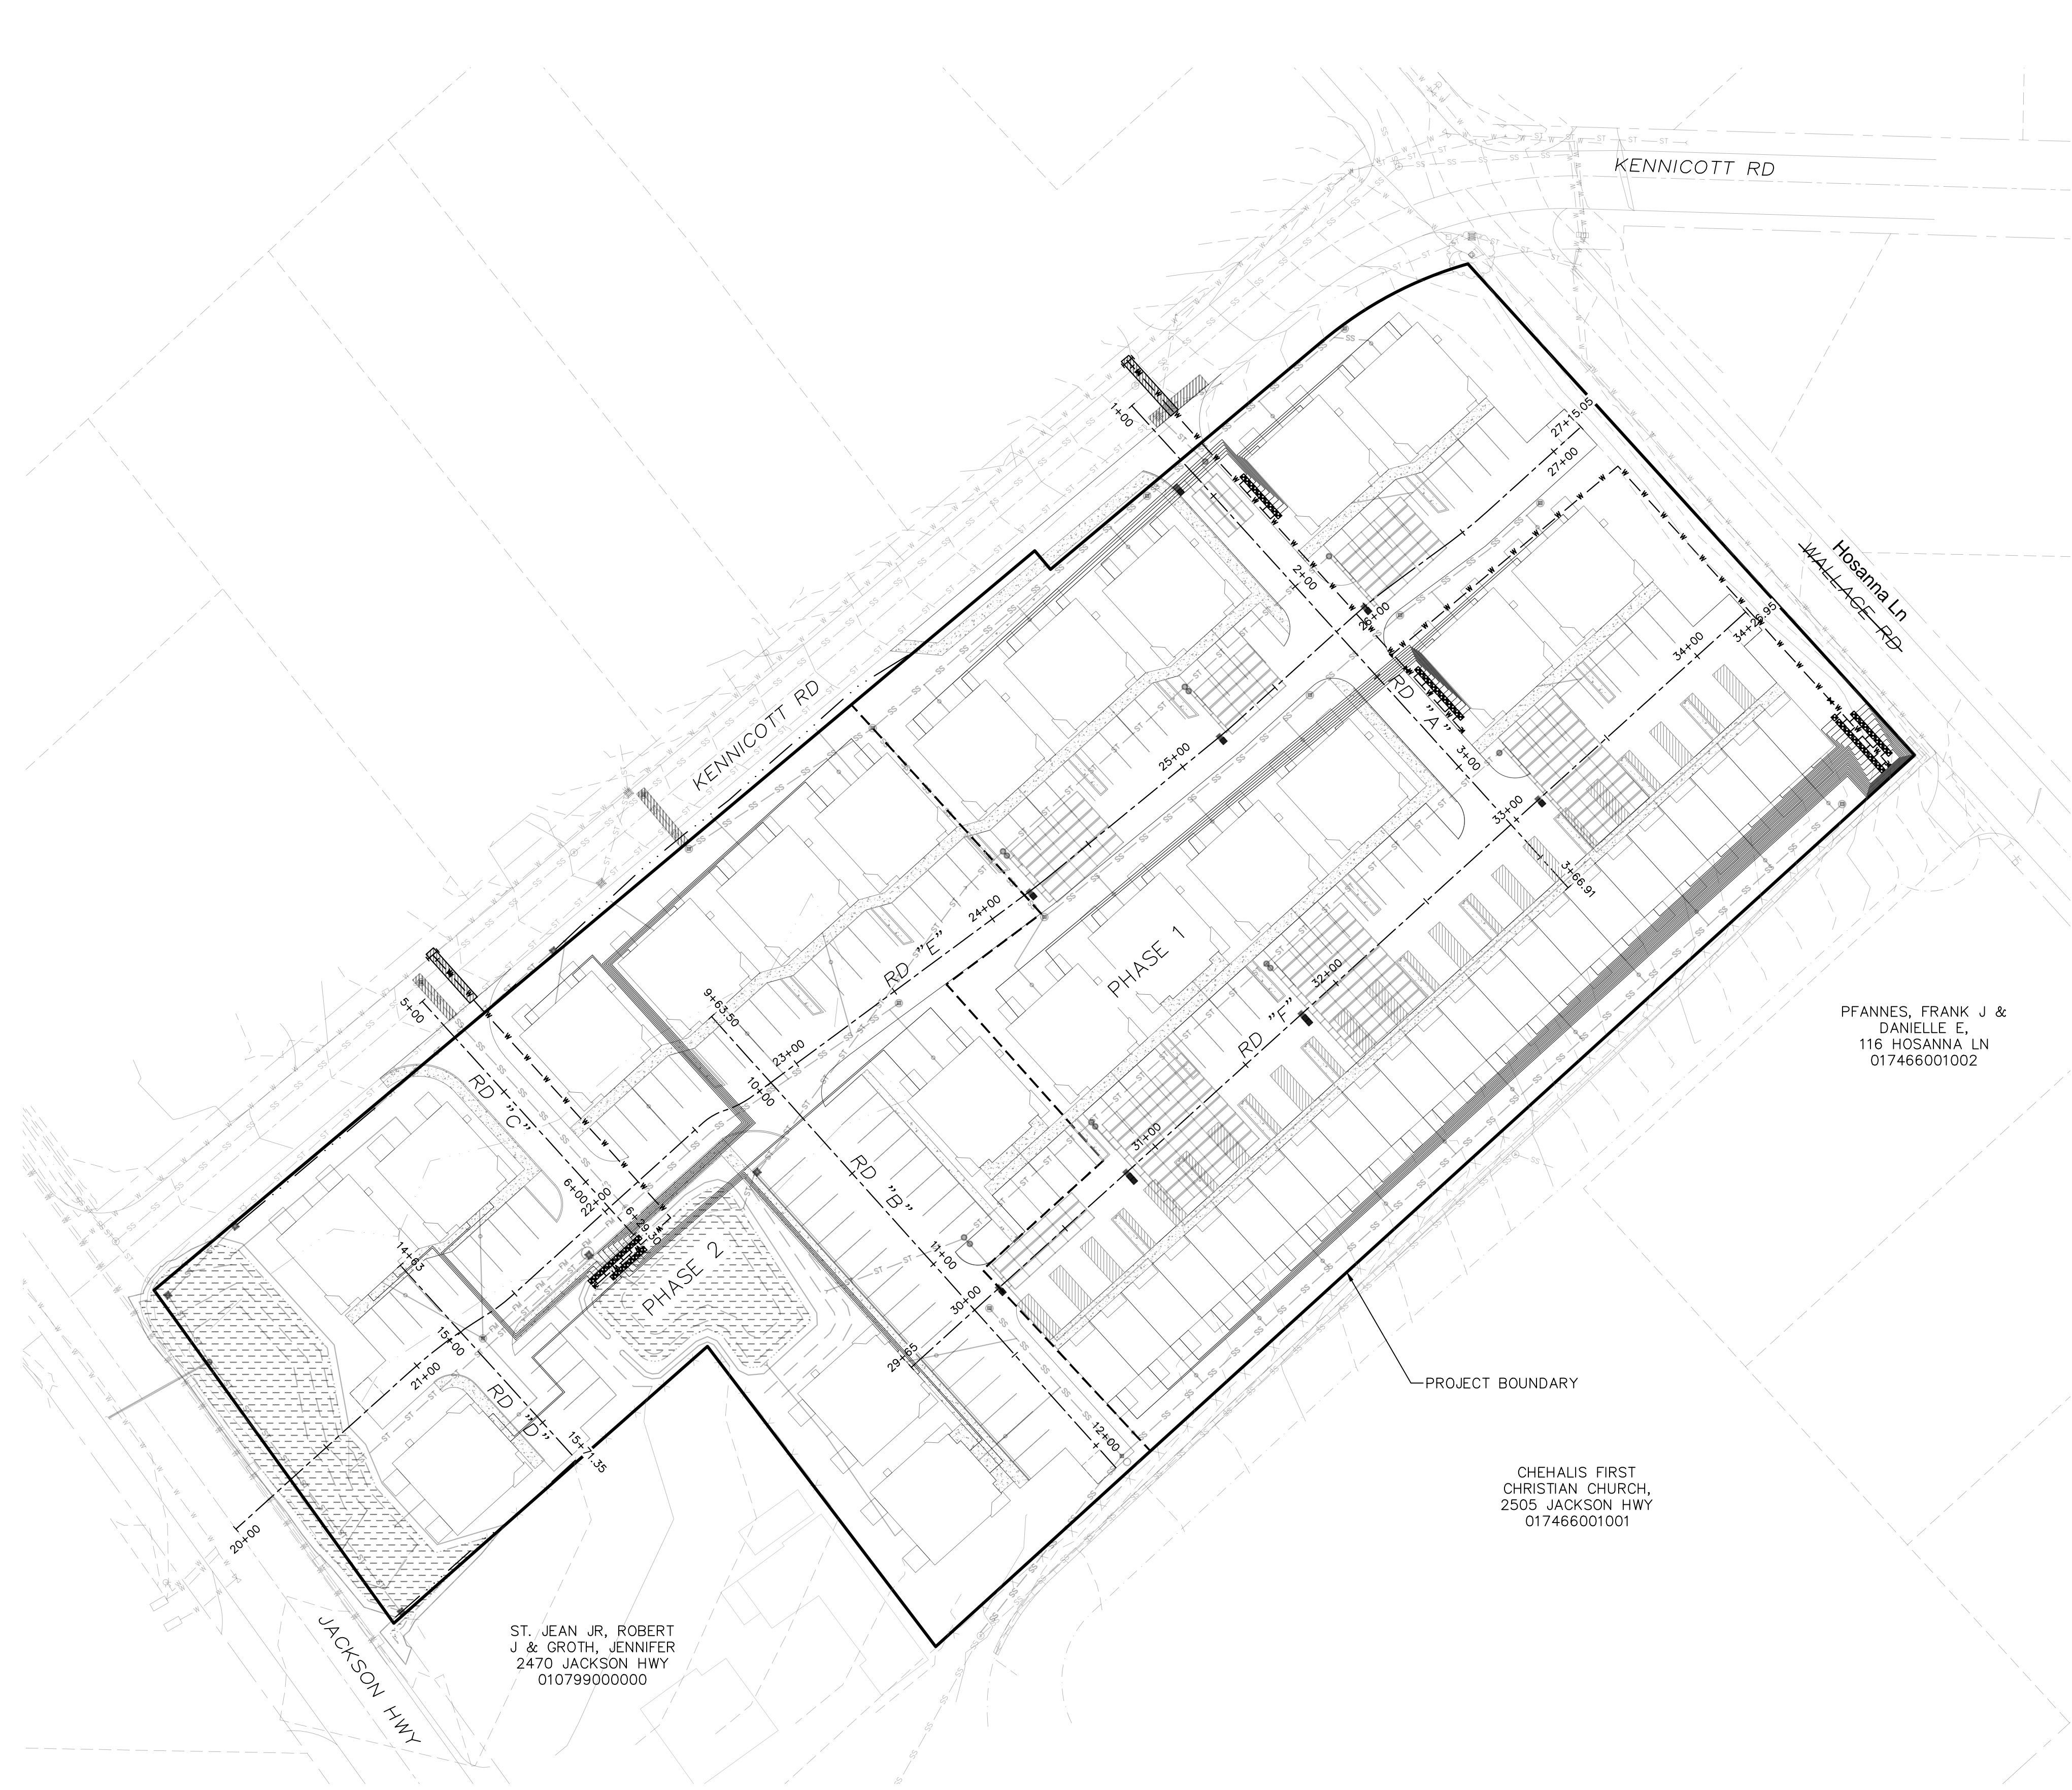


ST. JEAN JR, ROBERT
J & GROTH, JENNIFER
2470 JACKSON HWY
010799000000

PFANNES, FRANK J &
DANIELLE E,
116 HOSANNA LN
017466001002

CHEHALIS FIRST
CHRISTIAN CHURCH,
2505 JACKSON HWY
017466001001

DRAWING TITLE: FULL SITE WATER PLAN		CHECKED: AF
SCALE: 1:40	DATE: 02/22/21	DRAWN: SD
PROJECT NAME: JACKSON VILLA 4		

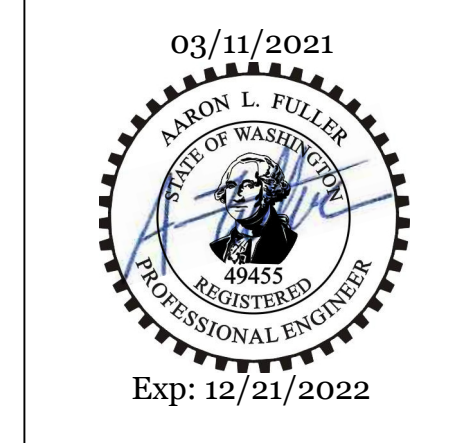

FULLER DESIGNS
1101 KRESKY AVE
CENTRALIA, WA 98531
(360) 807-4420

REV.	DESCRIPTION	DATE
0	PRELIMINARY - FOR PERMIT	02/22/21
1		

PRELIMINARY
FOR PERMIT ONLY